

S 20
5-26-62

WATER WELL DRILLERS LOG


Date: May 26, 1962, Driller: Porter Drilling Co. County: Wayne
(Name)

(1) Owner of Land:	Description & Color of Materials Sand, Clay, Red Clay, Shell, etc.	Thick- ness Feet	Depth Feet
<u>Rush Singletary</u> (Name) <u>Rt. 3 Waynesboro</u> (Address)	<u>Clay</u>	<u>22</u>	<u>22</u>
(2) Location: <u>NE 1/4, SW 1/4, Sec. 1 T. 7 R. 7</u> <u>6</u> miles <u>south</u> of <u>Waynesboro</u> (distance) (direction) (Nearest Town)	<u>sand</u>	<u>10</u>	<u>32</u>
(3) Topography: <u>hilly</u> (Hilly) (Flat) (Level)			
(4) Purpose of Well: <u>domestic</u> (Domestic Irrigation Municipal, Industrial, Other)			

Information upon completion of well:

- (1) Diameter 2" inches.
- (2) Total Depth 32' feet.
- (3) Water Level 20 feet below top of ground.
- (4) Cased to 26', Size 2"
- (5) Screen: Size 1 1/4", Length 6'
- (6) Were any formations sealed against pollution?
no yes, X no.

If YES depth of formation _____
Why _____
Drillers Remarks: _____

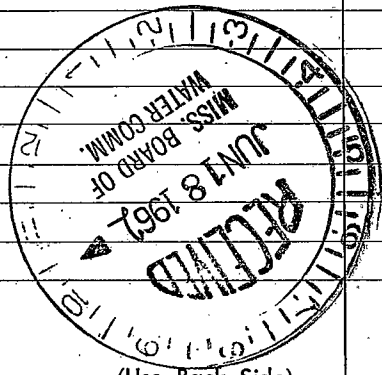

(Use Back Side)

Well No.

