

Wayne
322
7-67

MISSISSIPPI
BOARD OF WATER COMMISSIONERS
416 North State Street
Jackson, Mississippi 39201

WATER WELL DRILLERS LOG

July 7 1967 Porter Drilling Co Wayne
date well completed firm name county well located

LANDOWNER: Lon Bunch

description of formations encountered

from to

At 322 Hayesboro, Miss.
(mailing address)

WELL LOCATION:

sec. 2 T. 7 N. R. 7 E. W. W
2 miles SE of Hayesboro
(distance) (direction) (nearest town)

WELL PURPOSE: home
(home, irrigation, municipal, industrial)

WELL COMPLETION DATA:


- (1) diameter (inches) 2"
(2) total depth (feet) 87'
(3) static water level (feet) 57 below above top of ground.
(4) casing steel, 81',
(material) (depth)
2" if telescope see back.
(size)
(5) screen 6', 81'
(length) (depth to top)
1 1/4 90 ga brass jacket
(size) (material)
(6) pump 1 7
(HP) (yield gpm)
elec.
(type power)
(7) electric log no
(yes or no)

(organization running log)

(8) how well bottom plugged flank screen


DRILLERS REMARKS:

description of formations encountered	from	to
red clay	0	7
blue chalk	7	10
red sand & red chalk	10	14
red chalk	14	18
blue chalk	18	40
brown chalk	40	44
blue chalk	44	52
fine sand	52	56
fine sand & chalk	56	68
fine red sand	68	77
thin rock		77
fine clay white sand	77	87
stop on chalk		

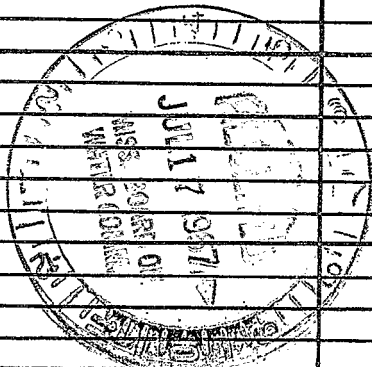

If well telescopes please sketch and show depths.

GROUND LEVEL

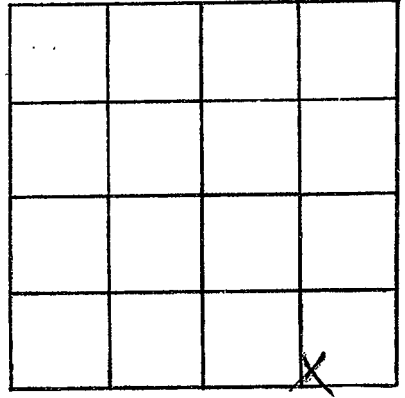

SECTION 2

Please indicate well location X.

ADDITIONAL INFORMATION

If more than one screen, show locations of each on sketch.