

**WAYNE MISSISSIPPI BOARD OF WATER COMMISSIONERS**

*S 23*

**4-17-63 WATER WELL DRILLERS LOG**

Date: *April 17, 1963*, Driller: *Barton Drilling & Luge* County *Wayne*  
(Name)

- (1) Owner of Land: *Luther Mason*  
(Name)
- Qt 3 Waynesboro*  
(Address)
- (2) Location: *SW 1/4, SW 1/4, Sec. 2 T7R2*  
*5* miles *south*, of *Waynesboro*  
(distance) (direction) (Nearest Town)
- (3) Topography: *hilly*  
(Hilly) (Flat) (Level)
- (4) Purpose of Well: *domestic*  
(Domestic Irrigation  
Municipal, Industrial, Other)

Description & Color of Materials Sand, Clay, Red Clay, Shell, etc.	Thick- ness Feet	Depth Feet
<i>red clay</i>	<i>15</i>	<i>15</i>
<i>red sand</i>	<i>9</i>	<i>24</i>


**Information upon completion of well:**

- (1) Diameter *2"* inches.
- (2) Total Depth *24'* feet.
- (3) Water Level *15'* feet below top of ground.
- (4) Cased to *20*, Size *2"*
- (5) Screen: Size *2"*, Length *3'*
- (6) Were any formations sealed against pollution?  
     yes, *X* no.

If YES depth of formation \_\_\_\_\_

Why \_\_\_\_\_

Drillers Remarks: \_\_\_\_\_

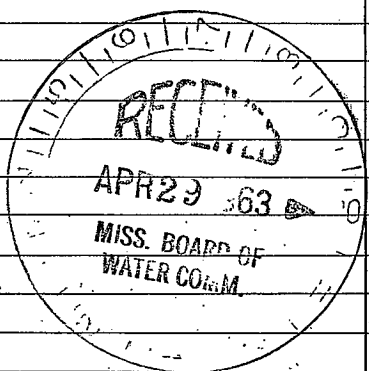

(Use Back Side)

Well No.

