

S 24

1-7-64

WATER WELL DRILLERS LOG

Date: Jan 7, 1964, Driller: Barton Drilling & Pipe County Wayne  
 (Name)

(1) Owner of Land: W. D. Tuttle  
 (Name)  
At. 3 Waynesboro, Miss  
 (Address)  
 (2) Location: NW 1/4, NW 1/4, Sec. 2 T 7 R 7  
5 miles south of Waynesboro  
 (distance) (direction) (Nearest Town)  
 (3) Topography: hilly  
 (Hilly) (Flat) (Level)  
 (4) Purpose of Well: domestic  
 (Domestic Irrigation  
 Municipal, Industrial, Other)


Description & Color of Materials Sand, Clay, Red Clay, Shell, etc.	Thick- ness Feet	Depth Feet
<u>red clay</u>	<u>10</u>	<u>10</u>
<u>chalk</u>	<u>16</u>	<u>26</u>
<u>fine sand &amp; chalk</u>	<u>10</u>	<u>36</u>
<u>chalk</u>	<u>2</u>	<u>38</u>
<u>sand &amp; chalk</u>	<u>5 1/2</u>	<u>43 1/2</u>
<u>stopped on chalk</u>		

Information upon completion of well:

(1) Diameter 2" inches.  
 (2) Total Depth 43 1/2 feet.  
 (3) Water Level 36' feet below top of ground.  
 (4) Cased to 38', Size 2"  
 (5) Screen: Size 1 1/4", Length 5'  
Johnson S-S  
 (6) Were any formations sealed against pollution?  
 \_\_\_\_\_ yes, X no.

If YES depth of formation \_\_\_\_\_  
 Why \_\_\_\_\_

Drillers Remarks: \_\_\_\_\_  
 \_\_\_\_\_  
 \_\_\_\_\_

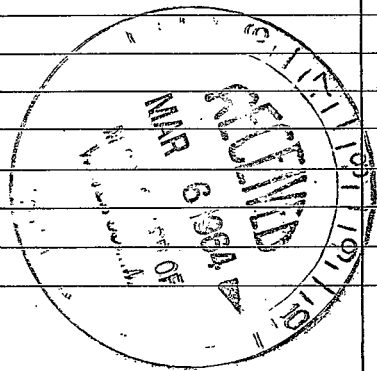

(Use Back Side)

Well No.

