

S26

8-19-64

WATER WELL DRILLERS LOG

Date: Aug 19, 1964; Driller: Porter Drilling & Pump Co. Wayne (Name)

(1) Owner of Land: Mrs. Linda Reynolds (Name)

Plot 3 Noyesboro (Address)

(2) Location: SE 1/4, SE 1/4, Sec. 3 T2R7

6 miles south of Noyesboro (distance) (direction) (Nearest Town)

(3) Topography: hilly (Hilly) (Flat) (Level)

(4) Purpose of Well: domestic (Domestic Irrigation Municipal, Industrial, Other)

Table with 4 columns: Description & Color of Materials, Thickness Feet, Depth Feet. Rows include: red sandy clay (20, 20), chalk & sand (14, 34), med sand, clean (18, 44), sand & chalk - thicker (8, 52), dual water, fine silty sand (7, 59), chalk (6, 65)

Information upon completion of well:

(1) Diameter 2 inches.

(2) Total Depth 46 feet.

(3) Water Level 36 feet below top of ground.

(4) Cased to 40, Size 2


(5) Screen: Size 1 1/4, Length 6' 60 ga

(6) Were any formations sealed against pollution? yes, X no.

If YES depth of formation

Why

Drillers Remarks:

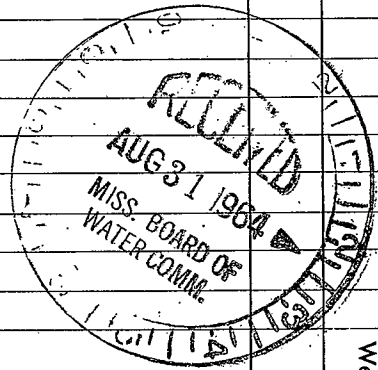

Well No.

(Use Back Side)

