

S27

7-31-61

WATER WELL DRILLERS LOG

Date: July 31, 1961, Driller: D. N. Porter, County Wayne

(Name)

(1) Owner of Land:	Description & Color of Materials Sand, Clay, Red Clay, Shell, etc.	Thick- ness Feet	Depth Feet
Hilly Utsey (Name)	clay	18	18'
Clara, Miss. (Address)	sand	7	25'
(2) Location: NW 1/4, NW 1/4, Sec. 7 T. 2 R. 2	blue chals	147	172
4 miles NW, of Clara (distance) (direction) (Nearest Town)	blue chals	137	162
(3) Topography: hilly (Hilly) (Flat) (Level)	fine blue sand with	1	
(4) Purpose of Well: domestic (Domestic Irrigation Municipal, Industrial, Other)	mixture of chals	12	174


Information upon completion of well:

- (1) Diameter 2" inches.
- (2) Total Depth 174' feet.
- (3) Water Level 51' feet below top of ground.
- (4) Cased to 165', Size 2"
- (5) Screen: Size 1 1/4 80gr, Length 9'
- (6) Were any formations sealed against pollution?
yes, no.

If YES depth of formation

Why

Drillers Remarks:

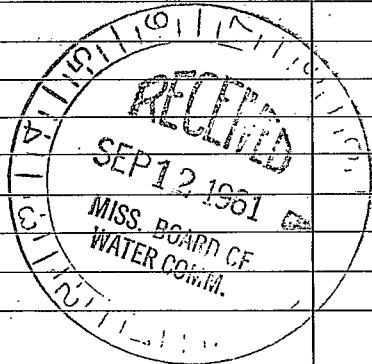

(Use Back Side)

Well No.

[The body of the page contains extremely faint and illegible text, likely bleed-through from the reverse side of the document. The text is too light to transcribe accurately.]