

S31

12-27-60

WATER WELL DRILLERS LOG

2-304

Date: Dec 27, 1960, Driller: D. N. Porter & Son County Wayne

(Name)

(1) Owner of Land: Sam Cochran

(Name)

Rt 3 Hayesboro, Miss

(Address)

(2) Location: SE 1/4, SW 1/4, Sec. 9 T7R7

1/2 miles west, of Clara

(distance)

(direction)

(Nearest Town)

(3) Topography: flat

(Hilly)

(Flat)

(Level)

(4) Purpose of Well: domestic

(Domestic Irrigation
Municipal, Industrial, Other)

Description & Color of Materials
Sand, Clay, Red Clay, Shell, etc.

Thick-
ness
Feet

Depth
Feet

clay & chert
sand

38'
9

38'
47'

Information upon completion of well:

(1) Diameter 2" inches.

(2) Total Depth 47' feet.

(3) Water Level 12' feet below top of ground.

(4) Cased to 41', Size 2"

(5) Screen: Size 1 1/4", Length 6'
80 ga.


(6) Were any formations sealed against pollution?

no

If YES depth of formation _____

Why _____

Drillers Remarks: _____

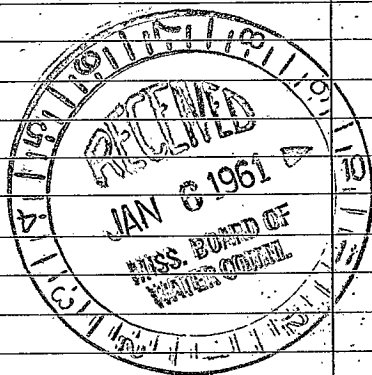

(Use Back Side)

Well No. _____

