

WATER WELL DRILLERS LOG

Date: July 2, 1965, Driller: Porter Drilling Co. Wayne
 (Name)

(1) Owner of Land: Lester Wade
 (Name)
At 3 Waynesboro Miss
 (Address)
 (2) Location: NW 1/4, SW 1/4, Sec. 10 T7 R7
6 miles S of Waynesboro
 (distance) (direction) (Nearest Town)
 (3) Topography: Hilly
 (Hilly) (Flat) (Level)
 (4) Purpose of Well: domestic
 (Domestic Irrigation
 Municipal, Industrial, Other)

Description & Color of Materials Sand, Clay, Red Clay, Shell, etc.	Thickness Feet	Depth Feet
<u>red clay</u>	<u>20</u>	<u>20</u>
<u>blue cl sh</u>	<u>18</u>	<u>38</u>
<u>fine sand</u>	<u>4</u>	<u>42</u>
<u>med sand</u>	<u>8</u>	<u>50</u>
<u>stagnant chkb</u>		

Information upon completion of well:


- (1) Diameter 2" inches.
- (2) Total Depth 50' feet.
- (3) Water Level 34' feet below top of ground.
- (4) Cased to 42', Size 2"
- (5) Screen: Size 1/4", Length 6'
- (6) Were any formations sealed against pollution?
60 ga

_____ yes, no.

If YES depth of formation _____

Why _____

Drillers Remarks: _____

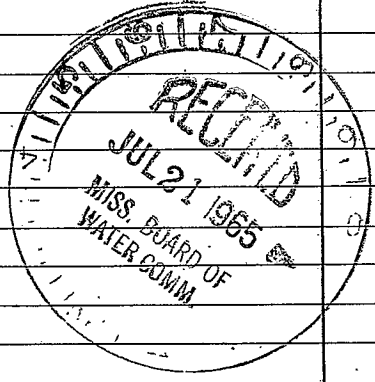

(Use Back Side)

Well No.

