

WAYNE MISSISSIPPI BOARD OF WATER COMMISSIONERS-

S37

4-4-63

WATER WELL DRILLERS LOG

Date: April 4, 1963, Driller: Porter Drilling & Log County Wayne  
 (Name)


(1) Owner of Land: Wes Hazel Bunch  
 (Name)  
At 3 Waynesboro  
 (Address)  
 (2) Location: SE 1/4, NW 1/4, Sec. 10 T7R7  
6 miles south of Waynesboro  
 (distance) (direction) (Nearest Town)  
 (3) Topography: Hilly  
 (Hilly) (Flat) (Level)  
 (4) Purpose of Well: domestic  
 (Domestic Irrigation  
 Municipal, Industrial, Other)

Description & Color of Materials Sand, Clay, Red Clay, Shell, etc.	Thick- ness Feet	Depth Feet
<u>red clay</u>	<u>8</u>	<u>8</u>
<u>red sand</u>	<u>7</u>	<u>15</u>
<u>red chalk</u>	<u>5</u>	<u>20</u>
<u>blue chalk</u>	<u>50</u>	<u>70</u>
<u>chalk sand</u>	<u>3</u>	<u>73</u>
<u>red clean sand</u>	<u>6</u>	<u>79</u>
<u>stratified blue chalk</u>		

Information upon completion of well:

(1) Diameter 2" inches.  
 (2) Total Depth 79' feet.  
 (3) Water Level 67' feet below top of ground.  
 (4) Cased to 70, Size 2"  
 (5) Screen: Size 1 1/4, Length 6'  
 (6) Were any formations sealed against pollution?  
 \_\_\_\_\_ yes, X no.

If YES depth of formation \_\_\_\_\_  
 Why \_\_\_\_\_  
 Drillers Remarks: \_\_\_\_\_

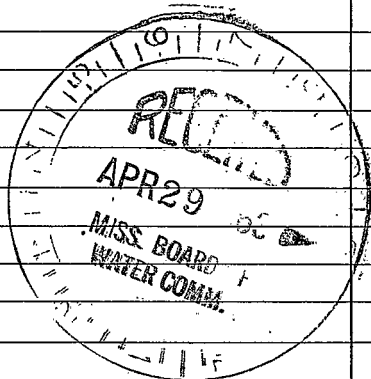

(Use Back Side)

Well No.

