

WAYNE

WELL DRILLERS LOG

5-302

Date: Oct 21, 1960, Driller: D. N. Porter Wayne County Wayne

(Name)

SO-21-60

- (1) Owner of Land: Roland Dean
(Name)
- At 3 Haysboro Miss.
(Address) ' 27
- (2) Location: 1/4, 1/4, Sec. 10 T7 R7,
3 miles NE, of Clara
(distance) (direction) (Nearest Town)
- (3) Topography: hilly
(Hilly) (Flat) (Level)
- (4) Purpose of Well: domestic
(Domestic Irrigation
Municipal, Industrial, Other)

Description & Color of Materials Sand, Clay, Red Clay, Shell, etc.	Thick- ness Feet	Depth Feet
<u>red clay</u>	<u>20</u>	<u>20'</u>
<u>sand</u>	<u>21</u>	<u>41'</u>
<u>sand mixed with shells</u>	<u>5'</u>	<u>46'</u>


Information upon completion of well:

- (1) Diameter 2" inches.
- (2) Total Depth 41' feet.
- (3) Water Level 27' feet below top of ground.
- (4) Cased to 35', Size 2"
- (5) Screen: Size 1/4, Length 6'
- (6) Were any formations sealed against pollution?
yes, X no.

If YES depth of formation _____

Why _____

Drillers Remarks: _____

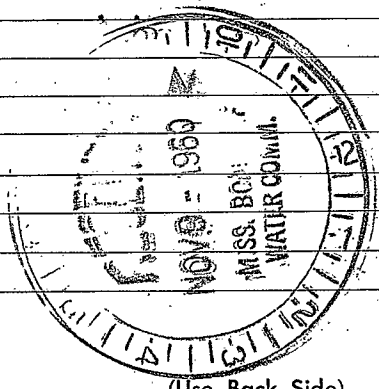

(Use Back Side)

Well No.

