

WAYNE MISSISSIPPI BOARD OF WATER COMMISSIONERS

June SAZ
+10-8-60

WATER WELL DRILLERS LOG

Date: 10-8, 1960, Driller: Peoples & Rutledge County Wayne
(Name)

(1) Owner of Land: Mrs Harry Ezell
(Name)
Chicora Miss
(Address)

(2) Location: 1/4, 1/4, Sec 21 T 8 R 6
5 miles West of Chicora
(distance) (direction) (Nearest Town)

(3) Topography: Hilly
(Hilly) (Flat) (Level)

(4) Purpose of Well: Domestic
(Domestic Irrigation
Municipal, Industrial, Other)

Description & Color of Materials Sand, Clay, Red Clay, Shell, etc.	Thick- ness Feet	Depth Feet
<u>Red Sandy Clay</u>	<u>30</u>	<u>30</u>
<u>yellow Sandy Clay</u>	<u>33</u>	<u>63</u>
<u>yellow Sandy Clay - 207270</u>		
<u>of Gumbo</u>		308
<u>Fine white Sand</u>	<u>38</u>	<u>308</u>

Information upon completion of well:

(1) Diameter 2" inches.

(2) Total Depth 308 feet.

(3) Water Level 120' feet below top of ground.

(4) Cased to 308, Size 2"


(5) Screen: Size 2", Length 6

(6) Were any formations sealed against pollution?
_____ yes, _____ no.

If YES depth of formation _____

Why _____

Drillers Remarks: _____

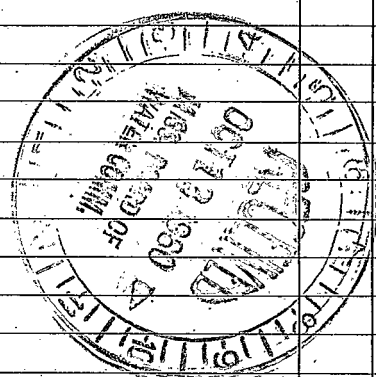

(Use Back Side)

Well No.

