

Wayne  
543  
10-66

MISSISSIPPI BOARD OF WATER COMMISSIONERS

WATER WELL DRILLERS LOG

Date: Oct 5, 1966, Drilled by Porter Drilling Co. County Wayne  
(Name)


(1) Owner of Land: Cowin Cochran  
(Name)  
Rt 3 Waynesboro, Miss  
(Address)  
(2) Location: SE 1/4, SW 1/4, Sec. 14 T 7 R 7,  
2 miles east of Clara,  
(distance) (direction) (Nearest Town)  
(3) Topography: Hilly  
(Hilly) (Flat) (Level)  
(4) Purpose of Well: domestic  
(Domestic Irrigation  
Municipal, Industrial, Other)

| Description & Color of Materials<br>Sand, Clay, Red Clay, Shell, etc. | Thick-<br>ness<br>Feet | Depth<br>Feet |
|---|------------------------|---------------|
| <u>red clay</u>   | <u>15</u>              | <u>15</u>     |
| <u>sand</u>   | <u>8</u>               | <u>23</u>     |
| <u>red chalk</u>  | <u>12</u>              | <u>35</u>     |
| <u>blue chalk</u>   | <u>37</u>              | <u>72</u>     |
| <u>sand &amp; chalk</u>   | <u>5</u>               | <u>77</u>     |
| <u>chalk &amp; sand</u>   | <u>3</u>               | <u>80</u>     |
| <u>fine sand &amp; some chalk</u>                                     | <u>17</u>              | <u>97</u>     |
| <u>fine clean sand</u>  | <u>5</u>               | <u>102</u>    |
| <u>chalky sand</u>  | <u>8</u>               | <u>110</u>    |
| <u>blue chalk</u>   | <u>6</u>               | <u>116</u>    |
| <u>med clean sand</u>   | <u>16</u>              | <u>132</u>    |
| <u>stopped while steel<br/>in sand</u>                                |                        |               |

Information upon completion of well:

(1) Diameter 2" inches.  
(2) Total Depth 132' feet.  
(3) Water Level 44' feet below top of ground.  
(4) Cased to 126', Size 2"  
(5) Screen: Size 1/4", Length 5'  
6 slot Johnson SS.  
set in with packer  
(6) Were any formations sealed against pollution?  
no

If YES depth of formation \_\_\_\_\_  
Why \_\_\_\_\_  
Drillers Remarks: \_\_\_\_\_

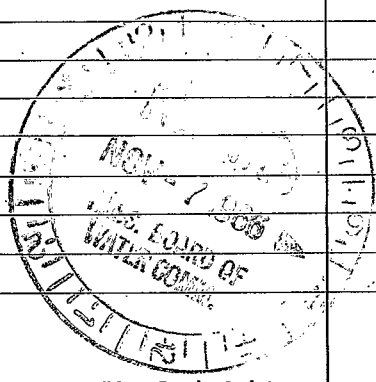

(Use Back Side)

Well No.

