

WAYNE
S 45

MISSISSIPPI BOARD OF WATER COMMISSIONERS

10-25-61

WATER WELL DRILLERS LOG

5

Date: Oct 25, 1961, Driller: A. N. Porter & Son County Wayne
(Name)


(1) Owner of Land: Sand L. Mulls
(Name)
At 3 Waynesboro, Miss
(Address)
(2) Location: SE 1/4, NW 1/4, Sec. 15 T7R7
1 miles SE of Clara
(distance) (direction) (Nearest Town)
(3) Topography: level
(Hilly) (Flat) (Level)
(4) Purpose of Well: domestic
(Domestic Irrigation
Municipal, Industrial, Other)

Description & Color of Materials Sand, Clay, Red Clay, Shell, etc.	Thick- ness Feet	Depth Feet
<u>Clay</u>	<u>10</u>	<u>10</u>
<u>blue shells</u>	<u>80</u>	<u>90</u>
<u>fine sand</u>	<u>5</u>	<u>95</u>
<u>course sand with a little chert</u>	<u>7</u>	<u>102</u>

Information upon completion of well:

(1) Diameter 2" inches.
(2) Total Depth 102' feet.
(3) Water Level 57 feet below top of
ground.
(4) Cased to 96' 6", Size 2"
(5) Screen: Size 1 1/4", Length 6
(6) Were any formations sealed against pollution?
no

If YES depth of formation _____
Why _____
Drillers Remarks: _____

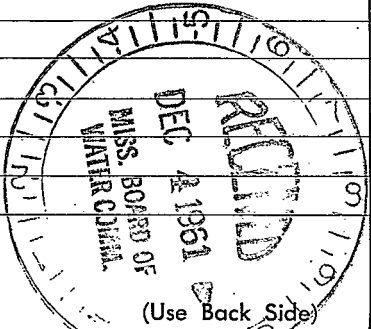

Well No.

