

WAYNE MISSISSIPPI BOARD OF WATER COMMISSIONERS

S 48

5-19-65 WATER WELL DRILLERS LOG

Date: May 19, 1965, Driller: Porter Drilling, Inc County Wayne
 (Name)


(1) Owner of Land: Hampton L. Waite
 (Name)
At 3 Waynesboro,
 (Address)
 (2) Location: SW 1/4, NE 1/4, Sec. 16 T 7 R 7
1/2 miles S, of Clava
 (distance) (direction) (Nearest Town)
 (3) Topography: flat
 (Hilly) (Flat) (Level)
 (4) Purpose of Well: domestic
 (Domestic Irrigation
 Municipal, Industrial, Other)

Description & Color of Materials Sand, Clay, Red Clay, Shell, etc.	Thick- ness Feet	Depth Feet
<u>red clay</u>	<u>8</u>	<u>8</u>
<u>sand</u>	<u>9</u>	<u>17</u>
<u>red chalk</u>	<u>3</u>	<u>20</u>
<u>blue chalk</u>	<u>2.5</u>	<u>4.5</u>
<u>sand + chalk</u>	<u>16</u>	<u>61</u>
<u>sand + chalk</u>	<u>32</u>	<u>93</u>
<u>fine red sand</u>	<u>20</u>	<u>113</u>

Information upon completion of well:

(1) Diameter 2" inches.
 (2) Total Depth 113' feet.
 (3) Water Level 29' feet below top of ground.
 (4) Cased to 97, Size 2"
 (5) Screen: Size 1 1/4, Length 6'
80 ga
 (6) Were any formations sealed against pollution?
 _____ yes, X no.

If YES depth of formation _____
 Why _____
 Drillers Remarks: _____

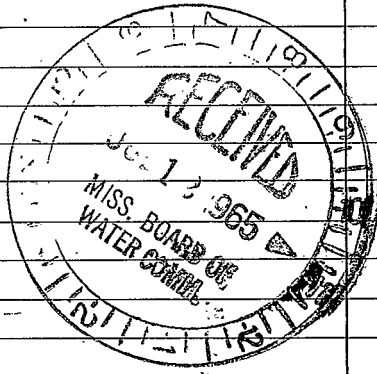

(Use Back Side)

Well No.

