

Wayne  
549  
12-68

MISSISSIPPI  
BOARD OF WATER COMMISSIONERS  
416 North State Street  
Jackson, Mississippi 39201

WATER WELL DRILLERS LOG

Dec 29 1967 Porter Drilling & Pipe Wayne  
date well completed firm name county well located

LANDOWNER: Jerry Palmer

description of formations encountered	from	to
sand	0	34
chalk	34	121
sand	121	134
chalk & sand	134	142
sand with chalk streaks	142	174
stiff chalk	174	206
clean sand	206	232
sand & some chalk	232	244
clean sand gravelly fine		
stagnant bottom	244	274
chalk	274	309
most clean sand	309	325
chalk	325	355
course clean sand	355	380
stop on chalk		

Box 14 Clara Miss.  
(mailing address)


WELL LOCATION:  
sec. 17 T-7 N R-7 E  
1 1/2 miles SW of Clara  
(distance) (direction) (nearest town)

WELL PURPOSE: home  
(home, irrigation, municipal, industrial)

WELL COMPLETION DATA:


- (1) diameter (inches) 2"
- (2) total depth (feet) 380'
- (3) static water level (feet) 78' below above top of ground.
- (4) casing steel 376'  
(material) (depth)  
2" if telescope see back.  
(size)
- (5) screen 5' 375'  
(length) (depth to top)  
1/4" Johnson S.S. 700  
(size) (material)
- (6) pump 1 6  
(HP) (yield gpm)  
elec  
(type power)
- (7) electric log no  
(yes or no)  
  
(organization running log)
- (8) how well bottom plugged  
flush point

DRILLERS REMARKS:

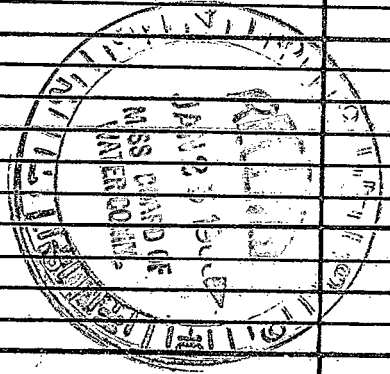

If well telescopes please sketch and show depths.

GROUND LEVEL

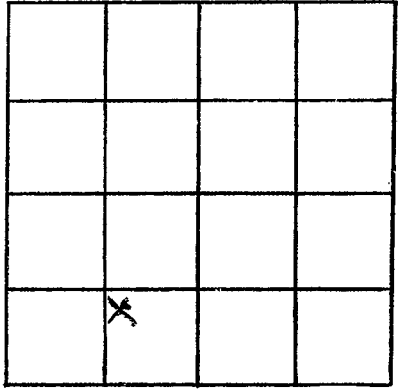

SECTION 17

Please indicate well location X.

ADDITIONAL INFORMATION

If more than one screen, show locations of each on sketch.