

Wayne
 550
 1-68

MISSISSIPPI
 BOARD OF WATER COMMISSIONERS
 416 North State Street
 Jackson, Mississippi 39201

WATER WELL DRILLERS LOG

Jan 1968 Peoples Drilling Co Wayne
 date well completed firm name county well located

LANDOWNER: Mrs. Spicy Hulson
 Gen. Del. Clara, Miss.
 (mailing address)


WELL LOCATION:
 sec. 20 T 70 N R 7 E
 2 miles SW of Clara
 (distance) (direction) (nearest town)

WELL PURPOSE: Home
 (home, irrigation, municipal, industrial)

WELL COMPLETION DATA:

(1) diameter (inches) 2"
 (2) total depth (feet) 147'
 (3) static water level (feet) 110' below top of ground.
 (4) casing Galv. 141' (material), (depth),
 7' (size) if telescope see back.
 (5) screen 6' 141' (length), (depth to top)
 2" Brass (size), (material)
 (6) pump 3/4 3 (HP), (yield gpm)
 elect (type power)
 (7) electric log No (yes or no)
 (organization running log)
 (8) how well bottom plugged Back Wash valve


description of formations encountered	from	to
yellow clay	0	15
white sand	15	21
yellowish sandy clay & sand streaks	21	39
Blue clay	37	74
white sand & blue clay streaks	74	100
Blue clay	100	117
white clay	117	126
white sand	126	147

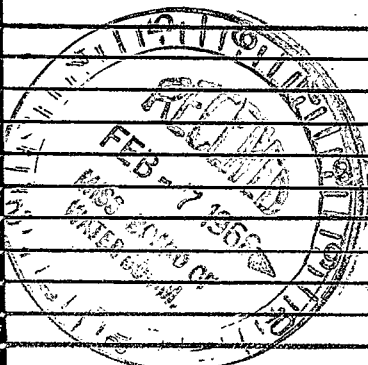

DRILLERS REMARKS:

If well telescopes please sketch and show depths.

GROUND LEVEL

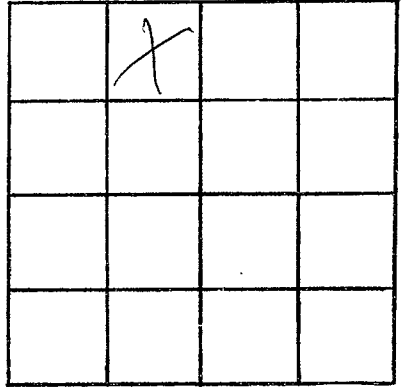

SECTION 20

Please indicate well location X.

ADDITIONAL INFORMATION

If more than one screen,
show locations of each on sketch.