

Wayne
552
1-67

MISSISSIPPI
BOARD OF WATER COMMISSIONERS
416 North State Street
Jackson, Mississippi 39201

WATER WELL DRILLERS LOG

Jan 18, 1967 Porter Drilling Co. Wayne
date well completed firm name county well located

LANDOWNER:
Gloyd Hudson
Rt 3 Waynesboro Miss
(mailing address)

| description of formations encountered | from | to |
|---------------------------------------|-----------|-----------|
| <u>red clay</u> | <u>0</u> | <u>5</u> |
| <u>white chalk</u> | <u>5</u> | <u>20</u> |
| <u>blue chalk</u> | <u>20</u> | <u>50</u> |
| <u>sand & chalk</u> | <u>50</u> | <u>53</u> |
| <u>mostly sand</u> | <u>53</u> | <u>60</u> |
| <u>stop on blue chalk</u> | | |

WELL LOCATION:
sec. 20 T. 7 N. R. 7 E
3 miles SW of Clara
(distance) (direction) (nearest town)


WELL PURPOSE: home
(home, irrigation, municipal, industrial)

WELL COMPLETION DATA:

- (1) diameter (inches) 2
- (2) total depth (feet) 60
- (3) static water level (feet) 35 below above top of ground.
- (4) casing galv. steel, 53
(material), (depth)
2" if telescope see back.
(size)
- (5) screen 6', 54'
(length), (depth to top)
1 1/4", 60 ga. brass packer
(size), (material)
- (6) pump 1/2, 6
(HP), (yield gpm)
elec.
(type power)
- (7) electric log no
(yes or no)

(organization running log)
- (8) how well bottom plugged 1/4" flash point

DRILLERS REMARKS: 1 1/4" screen
with 3' 1 1/4" brass pipe
stuck into casing with
rubber packer

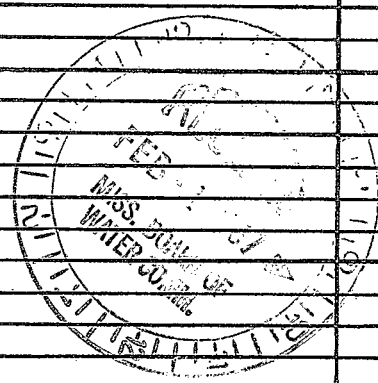

If well telescopes please sketch and show depths.

GROUND LEVEL

| | | | |
|--|--|--------------|---|
| | | | |
| | | | |
| | | | |
| | | | X |

SECTION 20

Please indicate well location X.

ADDITIONAL INFORMATION

If more than one screen, show locations of each on sketch.