

Wayne
554
10-67

MISSISSIPPI
BOARD OF WATER COMMISSIONERS
416 North State Street
Jackson, Mississippi 39201

WATER WELL DRILLERS LOG

Oct 19 1967 Porter Drilling, Inc. Wayne
date well completed firm name county well located


LANDOWNER: Chin Smith
Rt. 3 Waynesboro, Miss
(mailing address)

WELL LOCATION:
sec 26 T 7 N R 7 E
S W
4 miles SE of Clara
(distance) (direction) (nearest town)

WELL PURPOSE: home
(home, irrigation, municipal, industrial)

WELL COMPLETION DATA:
(1) diameter (inches) 2"
(2) total depth (feet) 174'
(3) static water level (feet) 30' below
top of ground.
(4) casing steel, 165'
(material) (depth)
2" if telescope see back.
(size)
(5) screen 6', 168'
(length) (depth to top)
1/4", 60 gal brass jacket
(size) (material)
(6) pump 2, 8
(HP) (yield gpm)
elec
(type power)
(7) electric log no
(yes or no)
(organization running log)
(8) how well bottom plugged


description of formations encountered	from	to
red clay & chalk	0	20
blue chalk	20	46
fine sand	46	55
blue chalk	55	100
sand & chalk	100	110
stiff chalk	110	160
med coarse sand	160	174
stagnant white steel in sand		

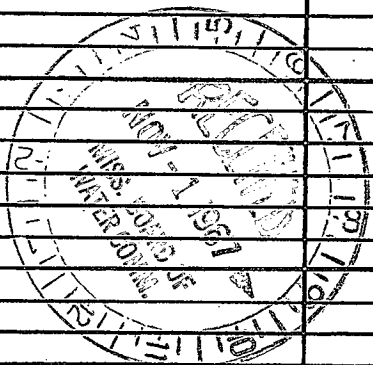

DRILLERS REMARKS:

If well telescopes please sketch and show depths.

GROUND LEVEL

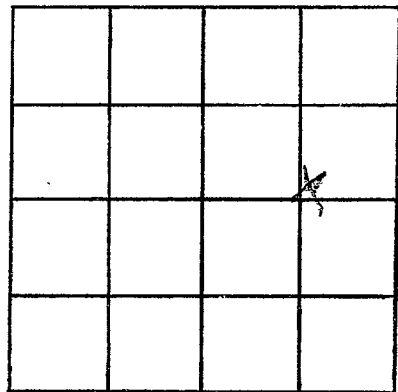

SECTION 26

Please indicate well location X.

ADDITIONAL INFORMATION

If more than one screen, show locations of each on sketch.