

S 55

12-29-62 WATER WELL DRILLERS LOG

Date: Dec 29, 1962, Driller: Porter Drilling & Supply Wayne County Wayne
 (Name)

(1) Owner of Land Alvin Aard
 (Name)
Rt 3 N Agnewboro, Miss
 (Address)
 (2) Location: NW 1/4, SE 1/4, Sec. 26 T. 7 R. 7
4 miles SE of Clara
 (distance) (direction) (Nearest Town)
 (3) Topography: flat
 (Hilly) (Flat) (Level)
 (4) Purpose of Well: domestic
 (Domestic Irrigation, Municipal, Industrial, Other)


Description & Color of Materials Sand, Clay, Red Clay, Shell, etc.	Thick- ness Feet	Depth Feet
red clay	17	17
white chalk	3	20
fine sand & chalk	23	43
blue chalk	44	87
fine tight sand	2	89
brown chalk	24	113
streak of blue sand & chalk	6	119
blue chalk	13	132
med grade clean sand	8	140
last blue chalk	12	152
med grade sand and some mixed chalk	26	178

Information upon completion of well:

(1) Diameter 2" inches.
 (2) Total Depth 178' feet.
 (3) Water Level 32' feet below top of ground.
 (4) Cased to 154, Size 2"
 (5) Screen: Size 1 1/4", Length 5'
Johnson S.S
 (6) Were any formations sealed against pollution?
 _____ yes, X no.

If YES depth of formation _____
 Why _____

Drillers Remarks: _____

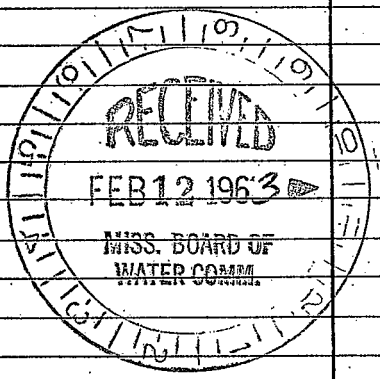

(Use Back Side)

Well No.

[The page contains extremely faint and illegible text, likely bleed-through from the reverse side of the document. The text is too light to transcribe accurately.]