

Wayne
 556
 11-67

MISSISSIPPI
 BOARD OF WATER COMMISSIONERS
 416 North State Street
 Jackson, Mississippi 39201

WATER WELL DRILLERS LOG

Nov 28 1967 Porter Drilling & Log Wayne
 date well completed firm name county well located

LANDOWNER: Williams
 Mills
 Rt 3 Nagsboro
 (mailing address)

| description of formations encountered | from | to |
|---------------------------------------|------|----|
| | | |

WELL LOCATION:
 sec. 27 T. 7 N. R. 7 E.
 S W
 2 miles S of Clara
 (distance) (direction) (nearest town)


| | | |
|--------------|----|----|
| red clay | 0 | 6 |
| blue chalk | 6 | 12 |
| fine sand | 12 | 15 |
| best chalk | 15 | 20 |
| blue chalk | 20 | 30 |
| red sand | 30 | 45 |
| thin rock | | 45 |
| blue chalk | 45 | 63 |
| sand & chalk | 63 | 66 |
| fine sand | 66 | 74 |

WELL PURPOSE: home
 (home, irrigation, municipal, industrial)

WELL COMPLETION DATA:
 (1) diameter (inches) 2"
 (2) total depth (feet) 74'
 (3) static water level (feet) 51' below above top of ground.
 (4) casing steel, 65' (depth)
 2" (size) if telescope see back.
 (5) screen 10' length, 64' depth to top
 1/4" 80 ga brass jacket (size) (material)
 (6) pump 3/4 HP, 7 (yield gpm)
 elec (type power)
 (7) electric log no (yes or no)
 (organization running log)


stepped on chalk

(8) how well bottom plugged
 plug pump
 DRILLERS REMARKS:

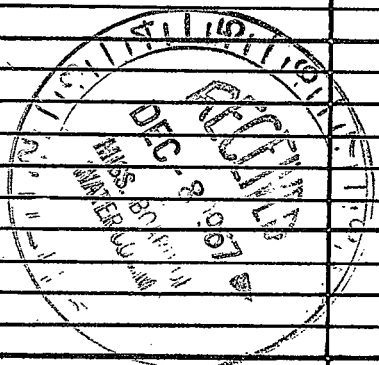

If well telescopes please sketch and show depths.

GROUND LEVEL

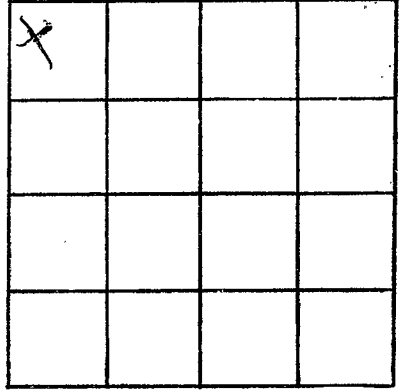

SECTION 27

Please indicate well location X.

ADDITIONAL INFORMATION

If more than one screen, show locations of each on sketch.