

WAYNE MISSISSIPPI BOARD OF WATER COMMISSIONERS

S58
5-22-61

WATER WELL DRILLERS LOG

305

Date: May 22, 1961, Driller: S. N. Porter & Son County Wayne
(Name)

(1) Owner of Land:	Description & Color of Materials Sand, Clay, Red Clay, Shell, etc.	Thick- ness Feet	Depth Feet
<u>Mrs Ine Betty Mills</u> (Name)	<u>Clay</u>	<u>20</u>	<u>20'</u>
<u>Rt 3. Waynesboro, Miss.</u> (Address)	<u>Chalk</u>	<u>20</u>	<u>40</u>
(2) Location: <u>SW 1/4, NW 1/4, Sec 27 T.7.R.7</u>	<u>sand & chalk</u>	<u>32</u>	<u>72'</u>
<u>3 1/2</u> miles <u>south</u> of <u>Clara</u> (distance) (direction) (Nearest Town)			
(3) Topography: <u>Hilly</u> (Hilly) (Flat) (Level)			
(4) Purpose of Well: <u>Domestic</u> (Domestic Irrigation Municipal, Industrial, Other)			


Information upon completion of well:

- (1) Diameter 2" inches.
- (2) Total Depth 72' feet.
- (3) Water level 30' feet below top of ground.
- (4) Cased to 66', Size 2"
- (5) Screen: Size 1/4", Length 6'
- (6) Were any formations sealed against pollution?
_____ yes, X no.

If YES depth of formation _____

Why _____

Drillers Remarks: _____

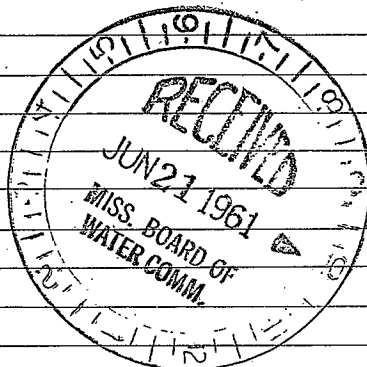

(Use Back Side)

Well No.

