

WAYNE

MISSISSIPPI BOARD OF WATER COMMISSIONERS

S⁵⁹

3-2-65

WATER WELL DRILLERS LOG

Date: March 2, 1965, Driller: Porter Drilling & Supply County Wayne

(Name)

(1) Owner of Land: William H. Flower

(Name)

Waynesboro Miss

(Address)

(2) Location: NW 1/4, SW 1/4, Sec. 28 T 7 R 710 miles south of Waynesboro

(distance)

(direction)

(Nearest Town)

(3) Topography: hilly

(Hilly)

(Flat)

(Level)

(4) Purpose of Well: domestic

(Domestic Irrigation

Municipal, Industrial, Other)

Description & Color of Materials
Sand, Clay, Red Clay, Shell, etc.Thick-
ness
FeetDepth
Feetred sandy clay66red sand1420blue chalk121med coarse sand1132chalk sand234stop on blue chalk

Information upon completion of well:

(1) Diameter 1 1/4 inches.(2) Total Depth 30 feet.(3) Water Level 11 feet below top of ground.(4) Cased to none, Size 28' 1 1/4" pipe(5) Screen: Size 1 1/4, Length 2 1/2


(6) Were any formations sealed against pollution?

yes, X no.

If YES depth of formation _____

Why _____

Drillers Remarks: _____

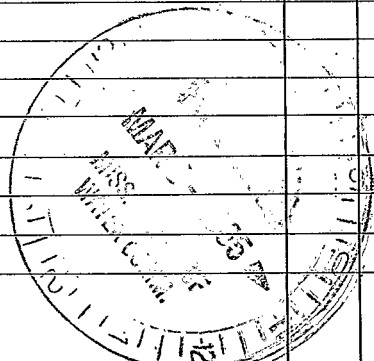

(Use Back Side)

Well No.

Mail this copy to Board of Water Commissioners 429 Miss. St. Jackson, Miss.

