

S60
11-63

WATER WELL DRILLERS LOG

Date: Nov, 1963, Driller: Peeples Drilling County Wayne
(Name)

(1) Owner of Land: Milla
(Name)

(Address)

(2) Location: 1/4, 1/4, Sec. T. R.
4 miles SE of Clara
(distance) (direction) (Nearest Town)

(3) Topography: Hilly
(Hilly) (Flat) (Level)

(4) Purpose of Well: Domestic
(Domestic Irrigation
Municipal, Industrial, Other)

Description & Color of Materials Sand, Clay, Red Clay, Shell, etc.	Thick- ness Feet	Depth Feet
<u>yellow sandy clay</u>	<u>42</u>	<u>42</u>
<u>Blue Clay</u>	<u>42</u>	<u>84</u>
<u>white sandy clay</u> <u>+ sand streaks</u>	<u>42</u>	<u>126</u>
<u>white clay</u>	<u>49</u>	<u>175</u>
<u>white sand</u>	<u>20</u>	<u>195</u>

Information upon completion of well:

(1) Diameter 2" inches.

(2) Total Depth 195 feet.

(3) Water Level 52 feet below top of ground.

(4) Cased to 189, Size 2"


(5) Screen: Size 2", Length 4'

(6) Were any formations sealed against pollution?
 yes, no.

If YES depth of formation

Why

Drillers Remarks:

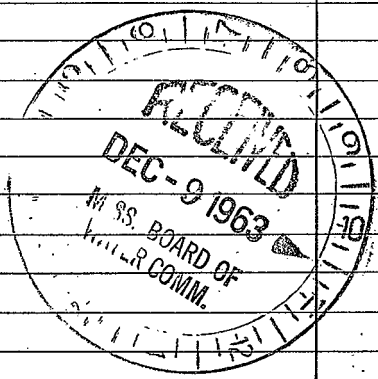

(Use Back Side)

Well No.

