

WAYNE
564
368

MISSISSIPPI
BOARD OF WATER COMMISSIONERS
416 North State Street
Jackson, Mississippi 39201

WATER WELL DRILLERS LOG

8-15 1968 Care Dickie Sewell Wayne
date well completed firm name county well located

LANDOWNER M. Fred Basin

description of formations encountered	from	to
Sand	0	2
yellow + pink streaked clay	2	10
Blue clay	10	12
GRAY CLAY	12	18
DARK BLUE CLAY	18	36
BROWNISH CLAY	36	40
Blue clay	40	69
VERY FINE WHITE SAND	69	70
Blue clay	70	86
med CRYSTAL SAND	86	96
w/ small BALLS MUD IN IT		
COARSE yellowish SAND	96	99
w/ small BALLS OF MUD		
DAR Blue CLAY	99	100

RT 3 WAYNESBORO MISS
(mailing address)

WELL LOCATION:


sec. 12 T. 7 N R. 7 E
S W
1 3/4 miles EAST of CHARA
(distance) (direction) (nearest town)

WELL PURPOSE:
(home, irrigation, municipal, industrial)

WELL COMPLETION DATA:


- (1) diameter (inches) _____
- (2) total depth (feet) _____
- (3) static water level (feet) _____ below above top of ground.
- (4) casing _____ (material) _____ (depth) _____
_____ (size) if telescope see back.
- (5) screen _____ (length) _____ (depth to top) _____
_____ (size) _____ (material)
- (6) pump _____ (HP) _____ (yield gpm) _____
_____ (type power)
- (7) electric log _____ (yes or no) _____
_____ (organization running log)
- (8) how well bottom plugged _____

DRILLERS REMARKS: attempted to pump well w/ log pump failed to pump more than 1 quart per hour quit well

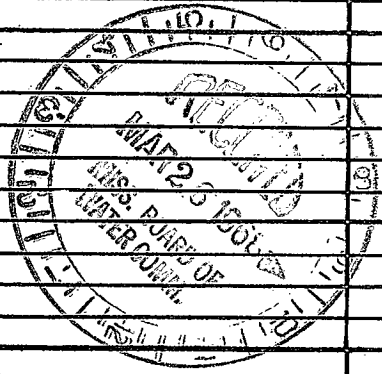

If well telescopes please sketch and show depths.

GROUND LEVEL

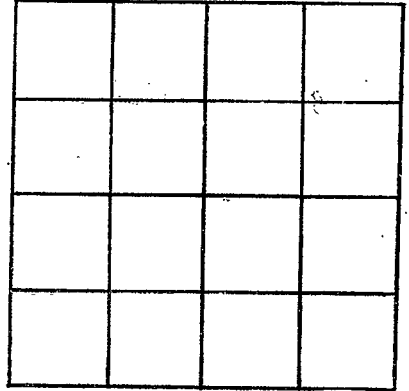

SECTION _____

Please indicate well location X.

ADDITIONAL INFORMATION

If more than one screen,
show locations of each on sketch.