

Wayne
566
7-68

MISSISSIPPI
BOARD OF WATER COMMISSIONERS
416 North State Street
Jackson, Mississippi 39201

WATER WELL DRILLERS LOG

July 2, 1968 date well completed
Porter Drilling & Exp. firm name
Wayne county well located

LANDOWNER:
Josh Vancosdahl
P.O. Box 321, Waynesboro, Miss.
(mailing address)

description of formations encountered	from	to
	0	8
sand	0	8
clay	8	15
fine silt & chalk	15	47
chalk & sand	47	72
blue chalk	72	104
med clean sand	104	112
stepped on sandy chalk		

WELL LOCATION:
sec 30 T 7 N R 7 E W
3 miles S of Clara
(distance) (direction) (nearest town)

WELL PURPOSE: home
(home, irrigation, municipal, industrial)


WELL COMPLETION DATA:
(1) diameter (inches) 2"
(2) total depth (feet) 112
(3) static water level (feet) 88' below top of ground.
(4) casing steel, 107' (material) (depth)
2" (size) if telescope see back.
(5) screen 5' length, 107' (depth to top)
1/4" slot Johnson S.S. (size) (material)
(6) pump 1 HP, 5 (yield gpm)
elec (type power)
(7) electric log no (yes or no)
(organization running log)

DRILLERS REMARKS:
screw bit in with packer

JUL 15 1968
MISS. BOARD OF
WATER COMM.

If well telescopes please sketch and show depths.

GROUND LEVEL

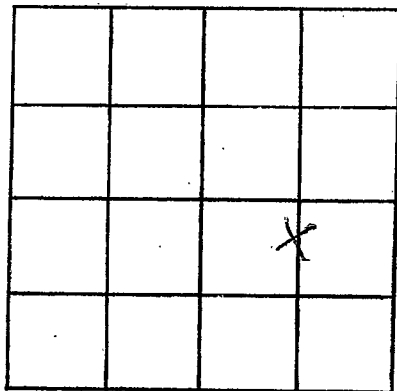

SECTION 30

Please indicate well location X.

ADDITIONAL INFORMATION

If more than one screen,
show locations of each on sketch.