

Wayne
567
5-68

MISSISSIPPI
BOARD OF WATER COMMISSIONERS
416 North State Street
Jackson, Mississippi 39201

CODED

WATER WELL DRILLERS LOG

May 16 1968 Porter Drilling & Log Wayne
date well completed firm name county well located

LANDOWNER: Benny Caves

description of formations encountered

from to

Clara, Miss.
(mailing address)

<u>red clay</u>	0	8
<u>chalk</u>	8	70
<u>sand & chalk</u>	70	80
<u>fine sand</u>	80	90
<u>loose clean sand</u>	90	99
<u>stratified white silt</u>		
<u>red sand</u>		

WELL LOCATION:

sec. 17 T. 7 (N) R. 7 (E)
1 1/2 miles SW of Clara
(distance) (direction) (nearest town)

WELL PURPOSE: Line
(home, irrigation, municipal, industrial)

WELL COMPLETION DATA:

- (1) diameter (inches) 2"
- (2) total depth (feet) 99'
- (3) static water level (feet) 64' ^{below} _{above} top of ground.
- (4) casing steel, 94'
(material) (depth)
2" if telescope see back.
(size)
- (5) screen 5', 99'
(length) (depth to top)
- (6) pump 1, 8
(HP) (yield gpm)
elec
(type power)
- (7) electric log no
(yes or no)

(organization running log)

(8) how well bottom plugged
flush point


DRILLERS REMARKS:

JUN 26 1968

MISS. BOARD OF
WATER COMM.

If well telescopes please sketch and show depths.

GROUND LEVEL

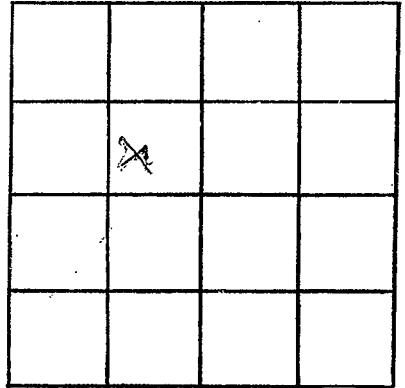

SECTION 17

Please indicate well location X.

ADDITIONAL INFORMATION

If more than one screen,
show locations of each on sketch.