

MISSISSIPPI
BOARD OF WATER COMMISSIONERS
416 North State Street
Jackson, Mississippi 39201

WATER WELL DRILLERS LOG

Wayne
568
6-68

June 6, 1968 Porter Drilling Co Wayne
date well completed firm name county well located

LANDOWNER: Coland Dean

description of formations encountered from to

243 Waynesboro, Miss
(mailing address)

rest clay 0 8
Chalky 8 18
sandy 18 42
slanted white shell
in loose sand

WELL LOCATION:
sec. 10 T. 7 N. R. 7 E
S W
1 1/2 miles NE of Clary
(distance) (direction) (nearest town)

WELL PURPOSE: home
(home, irrigation, municipal, industrial)

WELL COMPLETION DATA:

- (1) diameter (inches) 2"
- (2) total depth (feet) 40'
- (3) static water level (feet) 26 below above top of ground.
- (4) casing steel, 34'
(material) (depth)
2" if telescope see back.
(size)
- (5) screen 5', 35'
1/4" (length) (depth to top)
1/4", Johnson S.S. 2 1/2"
(size) (material)
- (6) pump 4, 8
(HP) (yield gpm)
elec
(type power)
- (7) electric log no
(yes or no)

(organization running log)

(8) how well bottom plugged flush point


DRILLERS REMARKS:

JUN 26 1968

MISS. BOARD OF
WATER COMM.

If well telescopes please sketch and show depths.

GROUND LEVEL

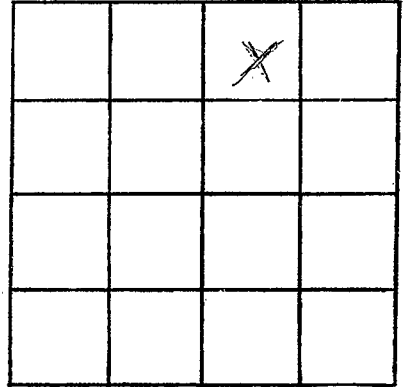

SECTION 10

Please indicate well location X.

ADDITIONAL INFORMATION

If more than one screen,
show locations of each on sketch.