

MISSISSIPPI
BOARD OF WATER COMMISSIONERS
416 North State Street
Jackson, Mississippi 39201

CODED
CODED

CODED
CODED

WATER WELL DRILLERS LOG

Wayne
569
10-30-68

Oct 30 1968 Porte Drilling & Log Wayne
date well completed firm name county well located

LANDOWNER: Bunch
Bunch
At 321 Augustin Miss
(mailing address)

description of formations encountered
from to
rest clay 0 10
gravel 10 42
stratified rock

WELL LOCATION:
sec. 10 T 7 N R 7 E
S W
1 1/2 miles NE of Clara
(distance) (direction) (nearest town)

WELL PURPOSE: Home
(home, irrigation, municipal, industrial)

WELL COMPLETION DATA:
(1) diameter (inches) 2"
(2) total depth (feet) 42'
(3) static water level (feet) 23 below above
top of ground.
(4) casing steel, 36'
(material) (depth)
2"
(size) if telescope see back.
(5) screen 1', 36'
(length) (depth to top),
1/4 boron brass
(size) (material)
(6) pump 3/4, 8
(HP) (yield gpm)
elec
(type power)
(7) electric log no
(yes or no)
(organization running log)

(8) how well bottom plugged
flush of gravel
DRILLERS REMARKS:

CODED


CODED

NOV 7 1968

MISS. DE. OF
WATER COM.

If well telescopes please sketch and show depths.

GROUND LEVEL

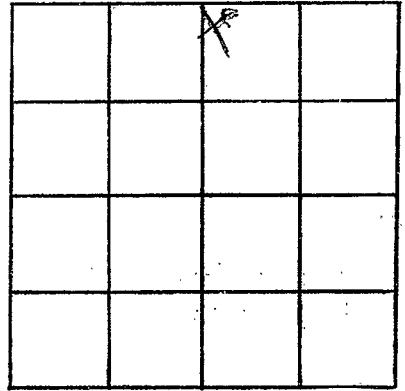

SECTION 10

Please indicate well location X.

ADDITIONAL INFORMATION

If more than one screen, show locations of each on sketch.