

Wayne Co
 970
 4-21-70

MISSISSIPPI
 BOARD OF WATER COMMISSIONERS
 416 North State Street
 Jackson, Mississippi 39201

WATER WELL DRILLERS LOG

April 21 1970 Booth Drilling Co. Wayne
 (date well completed) firm name county well located

LANDOWNER: Mr. Vernon Smith
At 3 Hanesboro Miss
 (mailing address)

description of formations encountered	from	to
rest clay	0	10
chalk	10	33
rest sandstone	33	54
shale with chert		
rest sand		

WELL LOCATION:
 sec 33 T. 7 S. R. 7 E. 033
4 miles S of Clarks
 (distance) (direction) (nearest town)

WELL PURPOSE: Home
 (home, irrigation, municipal, industrial)

- WELL COMPLETION DATA:
- (1) diameter (inches) 2"
 - (2) total depth (feet) 54'
 - (3) static water level (feet) 15' below above top of ground.
 - (4) casing steel 48'
 (material) (depth)
2" if telescope see back.
 (size)
 - (5) screen 6' 48'
 (length) (depth to top)
10 gal S.S.
 (size) (material)
 - (6) pump 1 72
 (HP) (yield gpm)
elec
 (type power)
 - (7) electric log no
 (yes or no)
 (organization running log)
 - (8) how well bottom plugged flush ground


6' 1 1/2' log on S.S. well
15' 1 1/2' log on pipe bit
in with packer
21' 1' log pipe

DRILLERS REMARKS:

MAY 20 1970
 MISS. BD. OF
 WATER COMM.

If well telescopes please sketch and show depths.

GROUND LEVEL

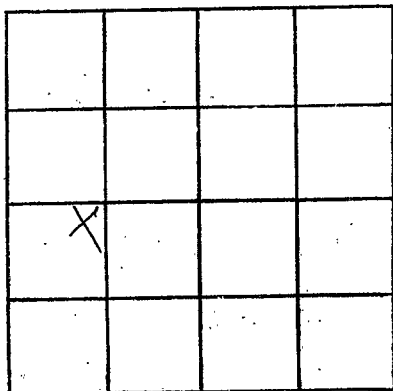

SECTION 33

Please indicate well location X.

ADDITIONAL INFORMATION

If more than one screen,
show locations of each on sketch.