

CODED

MISSISSIPPI
BOARD OF WATER COMMISSIONERS
416 North State Street
Jackson, Mississippi 39201

WATER WELL DRILLERS LOG

WAYNE
571
11-19-68

Mar 19 1968 date well completed
Robt. Dillingham firm name
Wayne county well located

LANDOWNER: John Clark
Robt. Dillingham Miss (mailing address)

description of formations encountered	from	to
red shale	0	14
sand	14	19
blue chalk	19	55
blue sand	55	77
blue shale	77	90
blue chalk	90	95

WELL LOCATION:
sec 24 T 7 N R 7 E
3 miles east of Clara (distance) (direction) (nearest town)

WELL PURPOSE: Home (home, irrigation, municipal, industrial)

WELL COMPLETION DATA:
(1) diameter (inches) 2"
(2) total depth (feet) 90'
(3) static water level (feet) 61 below top of ground.
(4) casing steel 74' (material) (depth) 2' (size) If telescope see back.
(5) screen 6' 74' (length) (depth to top) 1/4 20ga S.S. (size) (material)
(6) pump 1 8 (HP) (yield gpm) elec (type power)
(7) electric log no (yes or no)
(organization running log)

CODED


(8) how well bottom plugged
DRILLERS REMARKS:

11-19-68

MISS. Bd. OF WATER COMMISSIONERS

If well telescopes please sketch and show depths.

GROUND LEVEL

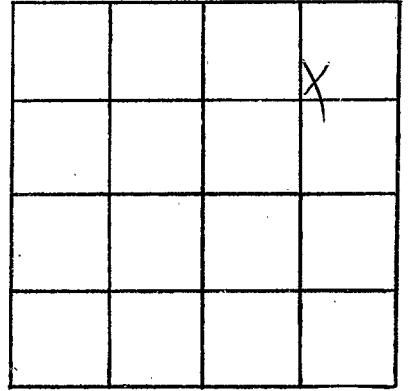

SECTION 24

Please indicate well location X.

ADDITIONAL INFORMATION

If more than one screen,
show locations of each on sketch.