

**CODED**

WAYNE

S-74

7-31-71

MISSISSIPPI  
BOARD OF WATER COMMISSIONERS  
416 North State Street  
Jackson, Mississippi 39201

WATER WELL DRILLERS LOG

**CODED**

July 31 1971 *Porter Drilling & Log* *Wayne*  
date well completed firm name county well located

LANDOWNER: *John Neal*

description of formations encountered	from	to
---------------------------------------	------	----

*At 3 Hainesboro Miss*  
(mailing address)

<i>Clay</i>	<i>0</i>	<i>16</i>
<i>ss</i>	<i>16</i>	<i>23</i>
<i>Chalk</i>	<i>23</i>	<i>105</i>

WELL LOCATION:  
sec *24* T *7* N R *7* E  
*3* miles *east* of *Clara*  
(distance) (direction) (nearest town)

<i>fine sand &amp; chalk</i>	<i>105</i>	<i>120</i>
<i>fine sand</i>	<i>120</i>	<i>148</i>
<i>stagnant on chalk</i>		

WELL PURPOSE: *home*  
(home, irrigation, municipal, industrial)

*11" 50 gal. S.S. hand line*

WELL COMPLETION DATA:

*well rubber packer*

- (1) diameter (inches) *2"*
- (2) total depth (feet) *148*
- (3) static water level (feet) *109* (below/above top of ground)
- (4) casing *steel* *139'*  
(material) (depth)
- 2"*  
(size) if telescope see back.
- (5) screen *11"* *137'*  
(length) (depth to top)
- 1/4"* *30 gm. S.S.*  
(size) (material)
- (6) pump *2* *10*  
(HP) (yield gpm)
- elec*  
(type power)
- (7) electric log *no*  
(yes or no)
- (organization running log)
- (8) how well bottom plugged *flush to ground*

*126" 1 1/4" drop pipe*

**CODED**


AUG 24 1971

MISS. Bd. OF WATER COM'RS

DRILLERS REMARKS:

If well telescopes please sketch and show depths.

GROUND LEVEL

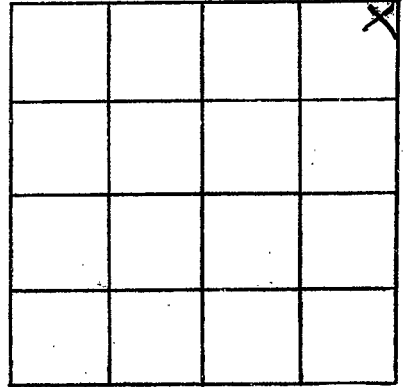

SECTION 24

Please indicate well location X.

ADDITIONAL INFORMATION

If more than one screen,  
show locations of each on sketch.