

Wayne

576

2-15-72

**CODED** MISSISSIPPI  
 BOARD OF WATER COMMISSIONERS  
 416 North State Street  
 Jackson, Mississippi 39201

FEB 29 1972

## WATER WELL DRILLERS LOG

Feb. 15, 1972 Porter Drilling & Log Wayne  
 date well completed firm name county well located

LANDOWNER: Eddie S. Turner

description of formations encountered

from

to

Rt 3 Nagsboro Miss.  
 (mailing address)

clay & chalk 0 23  
 fine dirt sand 23 32  
 striped on chalk  
 & sand

## WELL LOCATION:

sec. 30 T. 7 N. R. 7 E.  
10 miles south of Nagsboro  
 (distance) (direction) (nearest town)

screen sand packed with  
 coarse sand

WELL PURPOSE: Home  
 (home, irrigation, municipal, industrial)

5' 1 1/2" 6 shot SS screened  
 on end of cas.

## WELL COMPLETION DATA:

- (1) diameter (inches) 2"  
 (2) total depth (feet) 32'  
 (3) static water level (feet) 10 (below above top of ground.)  
 (4) casing steel, 27'  
 (material) (depth)  
2" if telescope see back.  
 (size)  
 (5) screen 5', 27'  
 (length) (depth to top)  
1 1/4", 6 shot S.S.  
 (size) (material)  
 (6) pump 30, 15  
 (HP) (yield gpm)  
elec  
 (type power)  
 (7) electric log no  
 (yes or no)

**CODED**


(organization running log)

(8) how well bottom plugged

DRILLERS REMARKS:

If well telescopes please  
sketch and show depths.

GROUND LEVEL

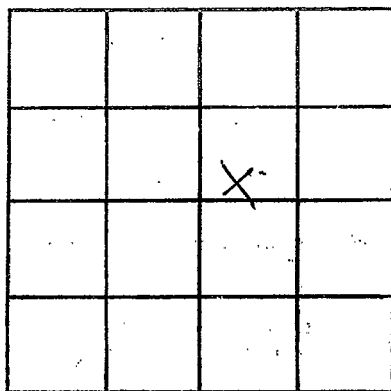

SECTION 30

Please indicate well location X.

ADDITIONAL INFORMATION

If more than one screen,  
show locations of each on sketch.