

TRCA

Wayne
S 77
2-1-72

CODED

MISSISSIPPI
BOARD OF WATER COMMISSIONERS
416 North State Street
Jackson, Mississippi 39201

MAR 17 1972

WATER WELL DRILLERS LOG

Feb 1 1972 Roy West water wells Wayne
date well completed firm name county well located

LANDOWNER: Wilbert Hudson
Rt 3 Waynesboro
Miss
(mailing address)

description of formations encountered	from	to
clay	0	12
sand	12	26
clay	26	55
sand	55	70

WELL LOCATION:
sec. 12 T 7 N R 7 E
4 miles S of Clarks
(distance) (direction) (nearest town)

WELL PURPOSE: home
(home, irrigation, municipal, industrial)


- WELL COMPLETION DATA:
- (1) diameter (inches) 2 in
 - (2) total depth (feet) 70
 - (3) static water level (feet) 46 below top of ground. above
 - (4) casing plastic 65
(material) (depth)
(size) if telescope see back.
 - (5) screen 5 65
(length) (depth to top)
2 in plastic
(size) (material)
 - (6) pump 1 12
(HP) (yield gpm)
Ria
(type power)
 - (7) electric log no
(yes or no)
 - (8) how well bottom plugged ushadue

CODED

DRILLERS REMARKS:

If well telescopes please sketch and show depths.

GROUND LEVEL

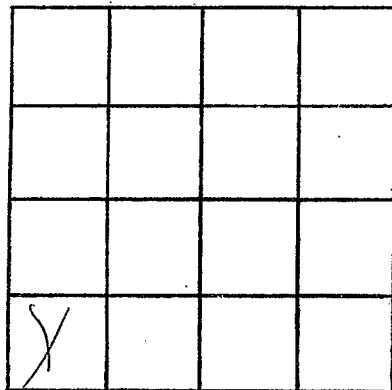

SECTION 17

Please indicate well location X.

ADDITIONAL INFORMATION

If more than one screen,
show locations of each on sketch.