

WAYNE
S 79
9-72

MISSISSIPPI
BOARD OF WATER COMMISSIONERS
416 North State Street
Jackson, Mississippi 39201

CODED

WATER WELL DRILLERS LOG

Sept 19 72 Peoples Drilling Co. Wayne
date well completed firm name county well located

LANDOWNER: <u>Will C. Robinson</u>	description of formations encountered	from	to
<u>Rt 3</u>			
<u>Waynesboro, Miss.</u> (mailing address)	<u>Yellow clay</u>	<u>0</u>	<u>21</u>
WELL LOCATION: sec. <u>1</u> T. <u>7</u> N. R. <u>7</u> E. <u>0</u> miles <u>S</u> of <u>Waba</u> (distance) (direction) (nearest town)	<u>Yellow sand</u>	<u>21</u>	<u>48</u>
WELL PURPOSE: <u>Home</u> (home, irrigation, municipal, industrial)	<u>White clay</u>	<u>48</u>	<u>105</u>
WELL COMPLETION DATA: (1) diameter (inches) <u>2"</u>	<u>Yellow clay + sand</u>		
(2) total depth (feet) <u>213'</u>	<u>Rock</u>	<u>105</u>	<u>126</u>
(3) static water level (feet) <u>73</u> ^{below} / _{above} top of ground.	<u>Yellow sandy clay</u>	<u>126</u>	<u>147</u>
(4) casing <u>Galv.</u> <u>208</u> (material) (depth) <u>2"</u> (size) if telescope see back.	<u>Hard white clay</u>	<u>147</u>	<u>180</u>
(5) screen <u>5'</u> <u>208</u> (length) (depth to top) <u>2 5/8</u> <u>stainless steel</u> (size) (material)	<u>White sand</u>	<u>180</u>	<u>213</u>
(6) pump <u>1</u> <u>0</u> (HP) (yield gpm) <u>electric</u> (type power)			
(7) electric log <u>no</u> (yes or no) <u></u> (organization running log)			
(8) how well bottom plugged <u>Back</u> <u>Wash valve</u>			
DRILLERS REMARKS:			


CODED

SEP 60 1972

MISS. BD. OF
WATER COM.

If well telescopes please sketch and show depths.

GROUND LEVEL

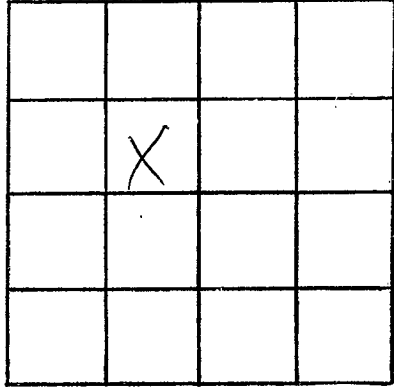

SECTION 1

Please indicate well location X.

ADDITIONAL INFORMATION

Multiple horizontal lines for additional information.

If more than one screen, show locations of each on sketch.