

WAYNE

581

2-23-73

MISSISSIPPI BOARD OF WATER COMMISSIONERS 416 North State Street Jackson, Mississippi 39201

CODED

WATER WELL DRILLERS LOG

2-23 1973 CARRS Well Service WAYNE date well completed firm name county well located

LANDOWNER: VON HENDERSON

description of formations encountered

from to

~~2145~~ WAYSBORO RT 3

Top Soil

0 1

WAYSBORO MISS (mailing address)

Yellow SAND

1 5

Yellow + GRAY CLAY

5 14

Yellow CLAY

14 18

Fine white SAND

18 40

White CLAY

40 42

Fine white SAND

42 64

Med white SAND

64 67

COARSE white SAND

67 84

WELL LOCATION:

sec 85 T 7 N R 7 E S W

9 miles WNW of BUC (distance) (direction) (nearest town)

WELL PURPOSE: HOME (home, irrigation, municipal, industrial)

still in same where last RETURNS

WELL COMPLETION DATA:

- (1) diameter (inches) 4 1/2"
(2) total depth (feet) 84'
(3) static water level (feet) 53 below top of ground
(4) casing Galv (material), 79 (depth)

CODED

(size) if telescope see back.

- (5) screen 5' (length), 79' (depth to top)

1 1/4 PVC (SLOT) (size) (material)

- (6) pump 1 (HP), 5 (yield gpm)

ELECT (type power)

- (7) electric log No (yes or no)

(organization running log)

- (8) how well bottom plugged Built in POINT


CODED

DRILLERS REMARKS:

Last CIRCL while DRILLING INSTALLED SCREEN FROM INSIDE ON 78" EUREKA CYLINDER

If well telescopes please sketch and show depths.

GROUND LEVEL

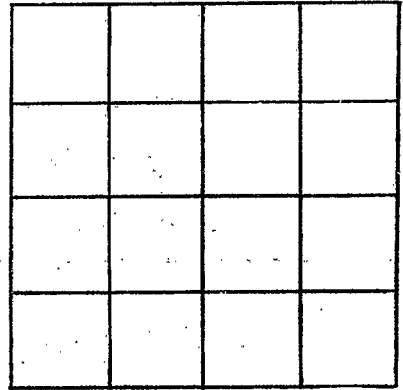

SECTION _____

Please indicate well location X.

ADDITIONAL INFORMATION

If more than one screen, show locations of each on sketch.