

WAYNE
582
4-10-73

MISSISSIPPI
BOARD OF WATER COMMISSIONERS
416 North State Street
Jackson, Mississippi 39201

WATER WELL DRILLERS LOG

CODED

April 10 1973 Boyer Drilling & Log Madison
date well completed firm name county well located

LANDOWNER: Bunch
L M Bunch Contractor
At 3 Haynesboro
(mailing address)

description of formations encountered	from	to
<u>red clay</u>	<u>0</u>	<u>15</u>
<u>chalk</u>	<u>15</u>	<u>50</u>
<u>sand & gravel</u>	<u>50</u>	<u>73</u>
<u>stratum on chalk</u>		

WELL LOCATION:
sec. 17 T. 7 N. R. 7 E.
1 1/2 miles SW of Clara
(distance) (direction) (nearest town)

42' 1/4" diam. pipe

WELL PURPOSE: home
(home, irrigation, municipal, industrial)

WELL COMPLETION DATA:

11" 80 ga S.S. well
in with 2 inches

- (1) diameter (inches) 2"
- (2) total depth (feet) 23'
- (3) static water level (feet) 32 below above top of ground.

- (4) casing steel 63'
(material) (depth)
2' if telescope see back.
(size)

- (5) screen 11" 62'
(length) (depth to top)
1/4" 80 ga S.S.
(size) (material)

- (6) pump 1 15
(HP) (yield gpm)
elec.
(type power)

- (7) electric log no
(yes or no)
(organization running log)

- (8) how well bottom plugged flush ground

DRILLERS REMARKS:


CODED

WAY 3 1973

MISS. DIV. OF
WATER RESOURCES

If well telescopes please sketch and show depths.

GROUND LEVEL

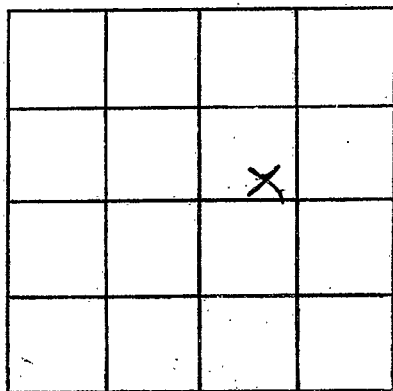

SECTION 17

Please indicate well location X.

ADDITIONAL INFORMATION

If more than one screen, show locations of each on sketch.