

MISSISSIPPI  
BOARD OF WATER COMMISSIONERS  
416 North State Street  
Jackson, Mississippi 39201

**CODED**

WATER WELL DRILLERS LOG

**WAYNE**  
**S83**  
**4-12-73**

April 12 1973 Rayliss St withville wayne  
date well completed firm name county well located

LANDOWNER: Brown wells

Rt 3  
description of formations encountered from to

Waynesboro (mailing address)  
Clay 0 10  
sandy clay 10 35  
Clay 35 45  
fine sand 45 60  
Bl. clay 60 240  
Sand 240 261

WELL LOCATION:  
sec. 17 T. 7 N. R. 7 E  
10 miles S of Waynesboro  
(distance) (direction) (nearest town)

WELL PURPOSE: Home  
(home, irrigation, municipal, industrial)

WELL COMPLETION DATA:

(1) diameter (inches) 2 in  
(2) total depth (feet) 261  
(3) static water level (feet) 60 below above top of ground.  
(4) casing galv 256  
(material) (depth)

(size) If telescope see back.

(5) screen 5 ft 256  
(length) (depth to top)  
2 in St Steel  
(size) (material)

(6) pump 1 hp 8  
(HP) (yield gpm)  
Rica  
(type power)

(7) electric log No  
(yes or no)

(organization running log)

(8) how well bottom plugged wash water


DRILLERS REMARKS:

**CODED**

JUN 15 1973

If well telescopes please sketch and show depths.

GROUND LEVEL

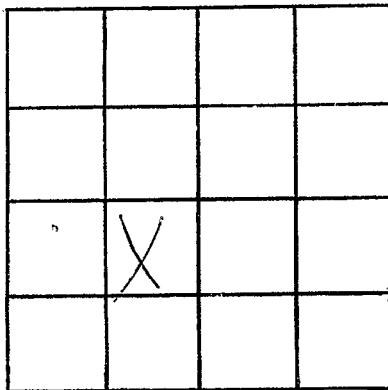

SECTION 17

Please indicate well location X.

ADDITIONAL INFORMATION

If more than one screen,  
show locations of each on sketch.