

COPIED

WAYNE
S 84
7-21-73

MISSISSIPPI
BOARD OF WATER COMMISSIONERS
416 North State Street
Jackson, Mississippi 39201

WATER WELL DRILLERS LOG

July 21 19 73 River Water Well Ser Wayne
(date well completed) firm name county well located

LANDOWNER: J. L. Cooley
Clara, Miss.
(mailing address)

WELL LOCATION:
sec. 17 T. 7 N R. 7 E
3 miles south of Clara
(distance) (direction) (nearest town)

WELL PURPOSE: Farm
(home, irrigation, municipal, industrial)

- WELL COMPLETION DATA:
- (1) diameter (inches) 4"
 - (2) total depth (feet) 85
 - (3) static water level (feet) 41' below top of ground.
 - (4) casing 2" (material), 81" (depth)
(size) if telescope see back.
 - (5) screen 4" (length), 85" (depth to top)
1 1/4" (size), Stainless Steel (material)
 - (6) pump 1 (HP), 6 (yield gpm)
Electric (type power)
 - (7) electric log No. (yes or no)
 - (organization running log)
 - (8) how well bottom plugged Drive Perit

description of formations encountered	from	to
top soil	0	1
Red clay	1	12
White Chalk	12	18
White fine sand	18	26
Blue Chalk	26	40
White fine sand	40	50
White Chalk	50	60
White fine sand	60	75
coarse white sand	75	85
total	85	Feet


COPIED

DRILLERS REMARKS: Good

AUG 9 1973

If well telescopes please sketch and show depths.

GROUND LEVEL

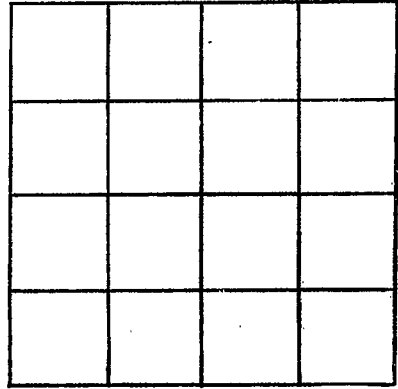

SECTION _____

Please indicate well location X.

ADDITIONAL INFORMATION

If more than one screen, show locations of each on sketch.