

BOARD OF WATER COMMISSIONERS
416 North State Street
Jackson, Mississippi 39201

WAYNE
385
11-28-73

WATER WELL DRILLERS LOG

Nov. 28 1973 Porter Drilling & Log Wayne
date well completed firm name county well located

LANDOWNER: Free Church of God

description of formations encountered	from	to
Clay	0	5
blue chalk	5	95
blue sand & chalk	95	102
chalk	102	125
from fine sand	125	131
chalk	131	168
from med sand	168	186
shell in sand		

Box 31 Waynesboro Miss
(mailing address)

WELL LOCATION:
sec. 20 T. 7 N. R. 7 E. W
2 miles SW of Clara
(distance) (direction) (nearest town)

WELL PURPOSE: church
(home, irrigation, municipal, industrial)

- WELL COMPLETION DATA:
- (1) diameter (inches) 2"
 - (2) total depth (feet) 186'
 - (3) static water level (feet) 72 (below/above top of ground)
 - (4) casing P.V.C. 181'
(material) (depth)
2 (size) If telescope see back.
 - (5) screen 5' 181'
(length) (depth to top)
2" galv P.V.C.
(size) (material)
 - (6) pump 1 8
(HP) (yield gpm)
elec
(type power)
 - (7) electric log no
(yes or no)
 - (organization running log)
 - (8) how well bottom plugged back wash valve

Clay	0	5
blue chalk	5	95
blue sand & chalk	95	102
chalk	102	125
from fine sand	125	131
chalk	131	168
from med sand	168	186
shell in sand		

88' 1" P.V.C. drop pipe

shell logs above screen


CODED

DRILLERS REMARKS:

DEC 18 1973

If well telescopes please
sketch and show depths.

GROUND LEVEL

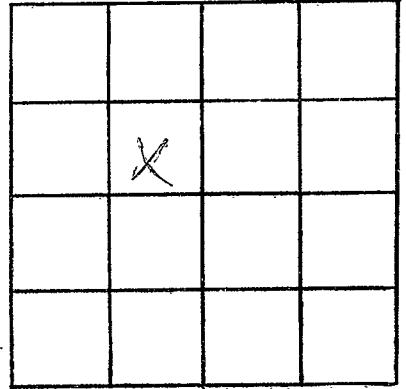

SECTION 20

Please indicate well location X.

ADDITIONAL INFORMATION

If more than one screen,
show locations of each on sketch.