

WAYNE
S 86
4-3-74


MISSISSIPPI
BOARD OF WATER COMMISSIONERS
416 North State Street
Jackson, Mississippi 39201
CODED

WATER WELL DRILLERS LOG

APRIL 3, 1974 McILWAIN WATER WELL SERVICE WAYNE
date well completed RT. 2, BOX 37 county well located

WAYNESBORO, MISS. 39367

LANDOWNER: description of formations encountered	from	to
HARVEY CAVES RT 3 WAYNESBORO, MISS (mailing address)	SANDY CLAY CLAY	0 6 6 20
WELL LOCATION: sec. 28 T. 7 N R. 7 W 3 miles S of CLARA (distance) (direction) (nearest town)	SAND CLAY SAND	20 22 22 30 30 33
WELL PURPOSE: HOME (home, irrigation, municipal, industrial)	CLAY	33 43
WELL COMPLETION DATA:	FINE SAND	43 50
(1) diameter (inches) 2"	WHITE GRADED	50 60
(2) total depth (feet) 194'	BLUE CLAY	60 93
(3) static water level (feet) 90' below top of ground.	SAND	93 97
(4) casing PVC 184' (material) (depth)	CLAY	97 121
2" if telescope see back. (size)	FINE SAND	120 130
(5) screen 10' 184' (length) (depth to top)	CLAY	130 133
2" PVC .008 (size) (material)	FINE SAND	133 137
(6) pump 1 6 (HP) (yield gpm)	CLAY	137 156
220 AC (type power)	SAND	151 153
(7) electric log NO (yes or no)	CLAY	153 165
(organization running log)	SAND	165 167
(8) how well bottom plugged	CLAY	167 180
	SAND	180 194

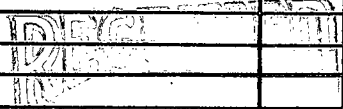


DRILLERS REMARKS:

MAY 9 1974

If well telescopes please sketch and show depths.

GROUND LEVEL

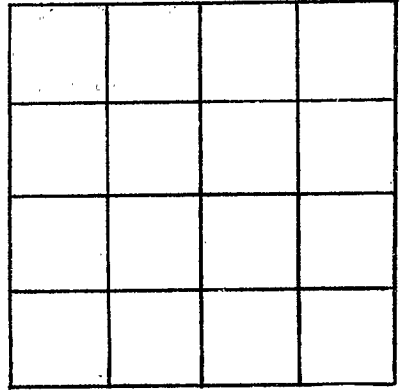

SECTION _____

Please indicate well location X.

ADDITIONAL INFORMATION

If more than one screen, show locations of each on sketch.