

BOARD OF WATER COMMISSIONERS
416 North State Street
Jackson, Mississippi 39201

587
Wayne 5/28/75

WATER WELL DRILLERS LOG

CODED.

May 28 1975 Ray West Water Wells Wayne
date well completed firm name county well located

LANDOWNER: Floyd West
RT 3

description of formations encountered	from	to
	Clay	0
pond clay	0	67
Sand	67	70
Clay	70	180
Sand	180	205

Waynesboro, Miss.
(mailing address)

WELL LOCATION:
sec. 19 T 20 N R 7 E
5 miles S of Clara
(distance) (direction) (nearest town)


WELL PURPOSE: home
(home, irrigation, municipal, industrial)

- WELL COMPLETION DATA:
- diameter (inches) 2 1/2
 - total depth (feet) 205
 - static water level (feet) 105 below top of ground.
 - casing PVC, 200,
(material) (depth)
_____ if telescope see back.
(size)
 - screen 5 ft, 200
(length) (depth to top)
1/4, st steel
(size) (material)
 - pump 1 hp, 6
(HP) (yield gpm)
R6A
(type power)
 - electric log No
(yes or no)

(organization running log)
 - how well bottom plugged wash hole


CODED

DRILLERS REMARKS:

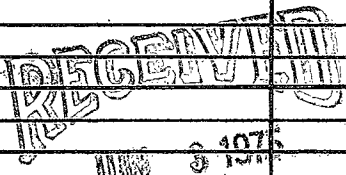

If well telescopes please sketch and show depths.

GROUND LEVEL

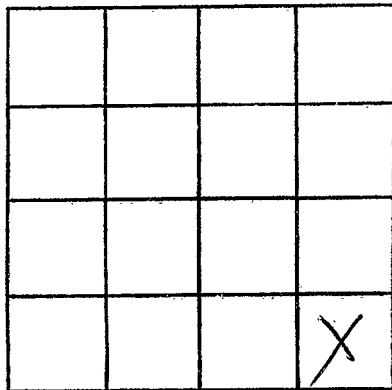

SECTION 19

Please indicate well location X.

ADDITIONAL INFORMATION

If more than one screen,
show locations of each on sketch.