

Wayne
5881
6-2-75

MISSISSIPPI
BOARD OF WATER COMMISSIONERS
416 North State Street
Jackson, Mississippi 39201

CODED

WATER WELL DRILLERS LOG

J. R. GREEN - WATER WELL DRILLING
195 RTE. 6, BOX 75A - PHONE 425-2237

WAYNE

6-2 date well completed

LAUREL, MISSISSIPPI 39440

county well located

LANDOWNER:
R. W. HUDSON
Rt # 3 Waynesboro, MS.
(mailing address)

WELL LOCATION:
sec 20 T 7 N R 7 E ^{13°}
3 miles S. of CLARA
(distance) (direction) (nearest town)

WELL PURPOSE:
(home) irrigation, municipal, industrial

WELL COMPLETION DATA:

- (1) diameter (inches) 4
- (2) total depth (feet) 143
- (3) static water level (feet) 82 ^{below} _{above} top of ground.
- (4) casing _____ (material), _____ (depth), _____ (size) if telescope see back.
- (5) screen 5' _____ 143 _____
(length) (depth to top)
2" x 0.008 _____ PVC _____
(size) (material)
- (6) pump 1 _____ 5 _____
(HP) (yield gpm)
110 VAC
(type power)
- (7) electric log NO _____
(yes or no)

(organization running log)
- (8) how well bottom plugged _____

description of formations encountered	from	to
yellow CHALK	0	10
" "	10	14
Sand	14	20
" "	20	25
Blue CHALK	25	30
" "	30	40
" "	40	50
" "	50	60
" "	60	70
" "	70	80
" "	80	90
" "	90	100
" "	100	105
the Sand	105	108
Blue CHALK	108	110
" "	110	120
" "	120	130
" "	130	138
Sand	138	140
" "	140	148
Blue CHALK	148	150
Sand	150	155
Blue CHALK	155	160


RECEIVED
AUG 4 1975

DRILLERS REMARKS:

MISS. BD. OF WATER COMM

If well telescopes please sketch and show depths.

GROUND LEVEL

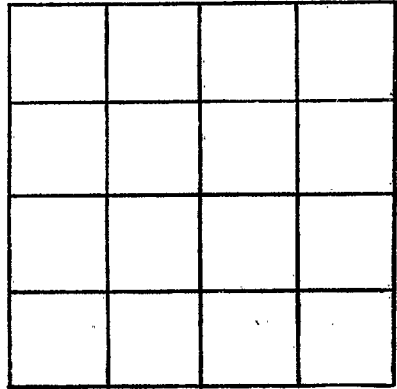

SECTION 20

Please indicate well location X.

ADDITIONAL INFORMATION

If more than one screen,
show locations of each on sketch.