

#2

CODED

Wayne
S 89
9-12-75

MISSISSIPPI
BOARD OF WATER COMMISSIONERS
416 North State Street
Jackson, Mississippi 39201

WATER WELL DRILLERS LOG


9/12 1975 P.O. Clark Wayne
date well completed firm name county well located

LANDOWNER: <u>Walter Cochran</u> <u>Clara Mrs</u>	description of formations encountered	from	to
(mailing address)	<u>yellow clay</u>	<u>0</u>	<u>21</u>
WELL LOCATION: ^{13P}	<u>Blue clay</u>	<u>21</u>	<u>63</u>
sec. <u>7</u> T. <u>7</u> (N) R. <u>7</u> E Clara <u>2</u> miles <u>West</u> of <u>Clark</u> (distance) (direction) (nearest town)	<u>Clay + Sand streaks</u>	<u>63</u>	<u>73</u>
WELL PURPOSE: <u>farm</u> (home, irrigation, municipal, industrial)	<u>Sand</u>	<u>73</u>	<u>82</u>
WELL COMPLETION DATA:			
(1) diameter (inches) <u>2</u>			
(2) total depth (feet) <u>82</u>			
(3) static water level (feet) <u>52</u> below top of ground.			
(4) casing <u>Galv Iron 77</u> (material) (depth)			
(size) if telescope see back.			
(5) screen <u>5'</u> <u>77</u> (length) (depth to top) <u>1 1/4"</u> <u>Solid Stainless</u> (size) (material)			
(6) pump <u>1 1/2</u> <u>7 1/2</u> (HP) (yield gpm) <u>E 230V</u> (type power)			
(7) electric log <u>No</u> (yes or no)			
(organization running log)			
(8) how well bottom plugged <u>BWU</u>			
DRILLERS REMARKS: <u>Set 12 A 9/8</u> <u>@ 7 1/2 ft used Crestones</u> <u>old pump Sta Pile</u>			

RECORDED
INDEXED
OCT - 6 1975

If well telescopes please sketch and show depths.

GROUND LEVEL

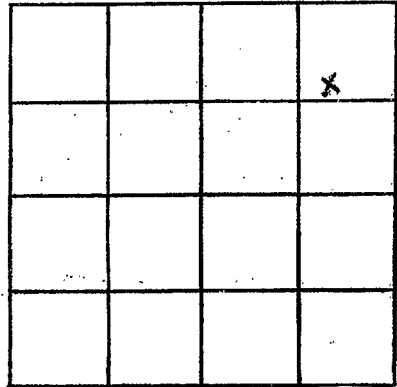

SECTION 7

Please indicate well location X.

ADDITIONAL INFORMATION

If more than one screen,
show locations of each on sketch.