

#1

Wayne
S 90
9-12-75

MISSISSIPPI
BOARD OF WATER COMMISSIONERS
416 North State Street
Jackson, Mississippi 39201

CODED

WATER WELL DRILLERS LOG

9/12 1975 G.P. Clark Wayne
date well completed firm name county well located


LANDOWNER: <u>Miller Cochran</u> <u>Clara, Miss</u>	description of formations encountered	from	to
(mailing address)	<u>Clay</u> <u>Clay & Sand streaks</u> <u>Sand</u>	<u>0</u>	<u>60</u> <u>75</u> <u>82</u>
WELL LOCATION: sec <u>1</u> T <u>7</u> N R <u>1</u> E 13P <u>2</u> miles <u>West</u> of <u>Clara</u> (distance) (direction) (nearest town)			
WELL PURPOSE: <u>Farm</u> (home, irrigation, municipal, industrial)			
WELL COMPLETION DATA:			
(1) diameter (inches) <u>2</u>			
(2) total depth (feet) <u>82</u>			
(3) static water level (feet) <u>60</u> below top of ground.			
(4) casing <u>Galvdrwn</u> <u>77</u> (material) (depth)			
_____ if telescope see back. (size)			
(5) screen <u>5</u> <u>77</u> (length) (depth to top)			
<u>1 1/4"</u> <u>Solid Glass</u> (size) (material)			
(6) pump <u>1 1/2</u> <u>5</u> (HP) (yield gpm)			
<u>2200</u> (type power)			
(7) electric log <u>NO</u> (yes or no)			
(organization running log)			
(8) how well bottom plugged <u>B.W.O</u>			
DRILLERS REMARKS: <u>Set 12" Jet</u> <u>73' used Customers old</u> <u>pump site later</u>			

RECEIVED
MAY 1975

APR - 6 1975

If well telescopes please sketch and show depths.

GROUND LEVEL

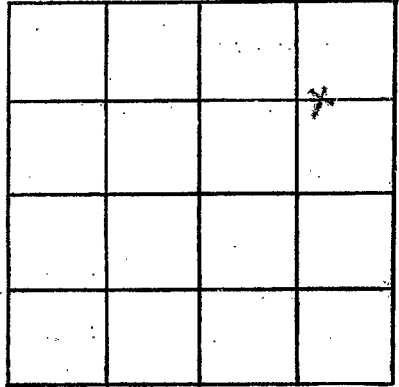

SECTION 7

Please indicate well location X.

ADDITIONAL INFORMATION

If more than one screen, show locations of each on sketch.