

WAYNE  
 591  
 10-26-76  
 Elwg # 295  
 10-26-19

MISSISSIPPI  
 BOARD OF WATER COMMISSIONERS  
 416 North State Street  
 Jackson, Mississippi 39201 CODED

WATER WELL DRILLERS LOG

date well completed 10-26-19 firm name TO GRINER DRILLING SERVICES county well located WAYNE

LANDOWNER: PENNZ OIL  
 PRODUCING CO., HOWSE  
 #1  
 (mailing address)

description of formations encountered	from	to
Red sand & clay	0	10
CLAY	10	20
SAND	20	180
CLAY	180	230
SAND & CLAY streaks	230	294
CLAY	294	312
SAND	312	326
CLAY	326	420
ROCKS & SAND streaks	420	484
CLAY & ROCKS	484	635
SAND streak, Fine	635	675
ROCK & CLAY	675	676
COLE		

WELL LOCATION: SE 1/4 NW 1/4 NE 1/4 SW 1/4  
 sec. 2 T. 7N R. 4E  
 S W  
 (distance) miles (direction) of (nearest town)

WELL PURPOSE: OIL WELL SUPPLY  
 (home, irrigation, municipal, industrial)

- WELL COMPLETION DATA:
- (1) diameter (inches) 3
  - (2) total depth (feet) 750
  - (3) static water level (feet) 135 below top of ground.
  - (4) casing steel 750 (material) (depth) (size) if telescope see back.
  - (5) screen 42 708 75 (length) (depth to top) (size) 3 3-slotted pipe 1008 (material)
  - (6) pump A.C. 45 (HP) (yield-gpm) (type power) Elect.
  - (7) electric log Yes (yes or no) MGS (organization running log)
  - (8) how well bottom plugged Back Wash Valve

Total depth drilled 750'  
 Well made from 315' - 325'


RECEIVED  
 MAR 18 1977

DRILLERS REMARKS:

MISS. BD. OF WATER COMMISSIONERS

If well telescopes please sketch and show depths.

GROUND LEVEL

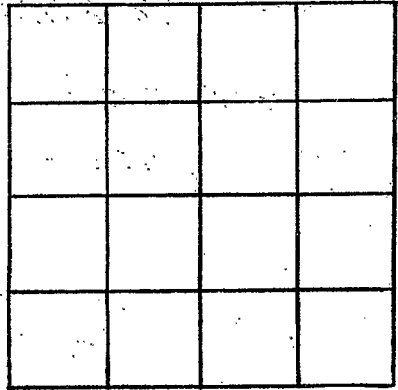

SECTION \_\_\_\_\_

Please indicate well location X:

ADDITIONAL INFORMATION

If more than one screen, show locations of each on sketch.