

088 40 43
32 35 37

PcA 3/14/98 C. P. CLARK
WATER WELL DRILLING

WAYNE
S 92
7-28-76

MISSISSIPPI
BOARD OF WATER COMMISSIONERS
416 North State Street
Jackson, Mississippi 39201
ROUTE 2
MISS. 39440
CODED

WATER WELL DRILLERS LOG

well # 3

7/28 1976
date well completed

C.P. Clark
firm name

Wayne
county well located

LANDOWNER: Clara Water
Asc. Clara, Miss
(mailing address)
WELL LOCATION:
sec. 10 T. 7(N) R. 7 E
S W
1 1/2 miles NW of Clara
(distance) (direction) (nearest town)

description of formations encountered	from	to
Sandy Clay	0	6
White Clay	6	26
Sand	26	61
Clay	61	114
Sand streaks	114	155
Hard Clay	155	160
Sand	160	169
Clay	169	185
Sand Streaks	185	223
Sand	223	248
Clay Sand Streaks	248	282
Hard Clay	282	286
Sand	286	338

WELL PURPOSE: Community
(home, irrigation, municipal, industrial)

- WELL COMPLETION DATA:
- (1) diameter (inches) 4
 - (2) total depth (feet) 338
 - (3) static water level (feet) 129 below top of ground.
 - (4) casing Black Iron 300 (material) (depth)
2 1/2 If telescope see back. (size)
 - (5) screen 20 318 (length) (depth to top)
2 1/2 Solid S.S. (size) (material)
 - (6) pump 5 65 (HP) (yield gpm)
2200 30 (type power)
 - (7) electric log No (yes or no)
 - (8) how well bottom plugged B.W.D.


DRILLERS REMARKS: Set Pump
S.H.P.F.W. @ 1890

RECEIVED
FEB - 1 1977

MISS. BD. OF WATER COMMISSIONERS

If well telescopes please sketch and show depths.

GROUND LEVEL

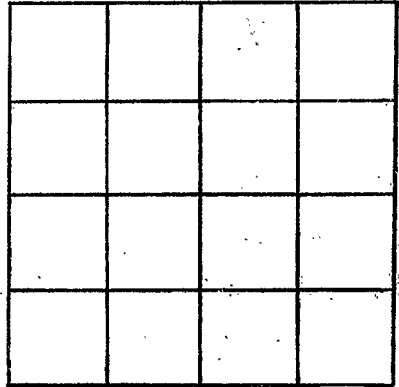

SECTION _____

Please indicate well location X.

ADDITIONAL INFORMATION

If more than one screen, show locations of each on sketch.