

Wayne
S-93

11-28-79

MISSISSIPPI
BOARD OF WATER COMMISSIONERS
416 North State Street
Jackson, Mississippi 39201

WATER WELL DRILLERS LOG

11-28 1979 Griner Drilling Wayne
date well completed firm name county well located

LANDOWNER:
DAMSON OIL
P.O. Box 4391
Houston, Texas 77210
(mailing address)

description of formations encountered	from	to
Sand	0	231
sand + chalk	231	315

WELL LOCATION: 1800N + 5W
No. 4-A Sabine Roy Corp. Sec 21 T 70N R 7E of W 1/4 of South of Clara
(distance) (direction) (nearest town)

WELL PURPOSE: oil field supply
(home, irrigation, municipal, industrial)

- WELL COMPLETION DATA:
- (1) diameter (inches) 3"
 - (2) total depth (feet) 315'
 - (3) static water level (feet) 15' below top of ground.
 - (4) casing steel 231' (material) (depth)
3' (size) if telescope see back.
 - (5) screen 42' 189' (length) (depth to top)
3" perforated (size) (material)
 - (6) pump - 75 (HP) (yield gpm)
AC (type power)
 - (7) electric log - (yes or no)
- (organization running log)

(8) how well bottom plugged orange peel

DRILLERS REMARKS:


DEPT. OF NATURAL RESOURCES
BUREAU OF LAND & WATER RESOURCES

JAN 9 1980

RECEIVED

If well telescopes please sketch and show depths.

GROUND LEVEL

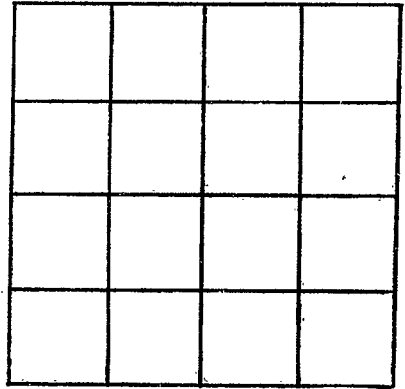

SECTION _____

Please indicate well location X.

ADDITIONAL INFORMATION

If more than one screen, show locations of each on sketch.