

CODED

CODED

Wayne
595
11-5-81

MISSISSIPPI
BOARD OF WATER COMMISSIONERS
416 North State Street
Jackson, Mississippi 39201

WATER WELL DRILLERS LOG

11-5 1981 date well completed
Tom Griffith firm name
Wayne county well located
Columbia, MS


LANDOWNER:	description of formations encountered	from	to
Inverco Oil Co. Jackson, MS (mailing address)	0-80 chalk		
WELL LOCATION: sec. 20 T1N R7E 2040S & S1E50 E of W. of 2.2 miles W. of Curran (distance) (direction) (nearest town)	80-140 - sand		
WELL PURPOSE: <u>oil</u> (home, irrigation, municipal, industrial)	140-390. chalk		
WELL COMPLETION DATA: (1) diameter (inches) <u>4"</u> (2) total depth (feet) <u>420</u> (3) static water level (feet) <u>30</u> below top of ground. (4) casing <u>steel</u> <u>1100</u> (material) (depth) <u>N/A</u> if telescope see back. (size) (5) screen <u>40</u> <u>380</u> (length) (depth to top) <u>4"</u> <u>steel slot</u> (size) (material) (6) pump <u>none</u> <u>95</u> (HP) (yield gpm) <u>Air</u> (type power) (7) electric log <u>(yes or no)</u> <u>N/A</u> (organization running log) (8) how well bottom plugged <u>covered</u>	390-420. sand		
DRILLERS REMARKS:			

DEPT. OF NATURAL RESOURCES
BUREAU OF LAND & WATER RESOURCES

JUN - 9 1982
RECEIVED

If well telescopes please sketch and show depths.

GROUND LEVEL

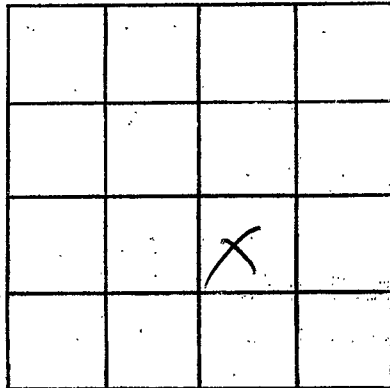

SECTION 70

Please indicate well location X.

ADDITIONAL INFORMATION

If more than one screen, show locations of each on sketch.