

MISSISSIPPI DEPARTMENT OF NATURAL RESOURCES

Bureau of Land and Water Resources

Southport Mall

P.O. Box 10631

Jackson, Mississippi 39209

WATER WELL DRILLERS LOG

WAYNE
 596
 11/13/86

11/13/86 date well completed 19 CARR'S WELL SER. firm name WAYNE county well located

LANDOWNER: INTERNATIONAL
 PAPER CO. MOBILE ALA
 (ENERGY DRILLING CO.)
 (mailing address)

WELL LOCATION:
 sec. 28 T. 7 N. R. 7 E
 4 miles S of CIARA
 (distance) (direction) (nearest town)

WELL PURPOSE:
 (home, irrigation, municipal, industrial)

WELL COMPLETION DATA:

(1) diameter (inches) 6"

(2) total depth (feet) 410

(3) static water level (feet) 148 below top of ground.

(4) casing PVC 390' (material) (depth)
 6" (size) if telescope see back.

(5) screen 20 380' (length) (depth to top)
 4" (size) 20 C. (material)

(6) pump BIR 117T (HP) (yield gpm)
 YIELD 30
 (type power)

(7) electric log NO (yes or no)

(organization running log)

(8) how well bottom plugged 3"
 B.W. PLUGGED

description of formations encountered	from	to
fill	0	1
TOP SOIL	1	2
CLAY	2	15
BLUE CLAY	15	88
FINE SD	88	93
BLUE CLAY	93	123
FINE SD	123	128
BLUE CLAY	128	190
TIGHT FIN. SD	190	199
CLAY	199	202
MED SD	202	206
CLAY	206	226
MED. FINE SD	226	301
CLAY	301	306
ROCKY CLAY	306	312
SAND	312	313
CLAY	313	319
SAND	319	322
CLAY	322	344
SAND	344	350
CLAY	350	365
SAND	365	372
CLAY	372	375
MED. CR. SAND	375	391
CLAY	391	394

RECEIVED

DEC 15 1986


Department of Natural Resources
 Bureau of Land & Water Resources

CODED

DRILLERS REMARKS:
 OIL FIELD WELL

If well telescopes please
sketch and show depths.

GROUND LEVEL

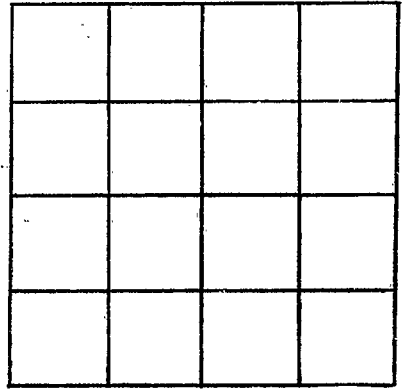

SECTION _____

Please indicate well location X.

ADDITIONAL INFORMATION

If more than one screen,
show locations of each on sketch.