

MISSISSIPPI DEPARTMENT OF NATURAL RESOURCES

Bureau of Land and Water Resources

Southport Mall

P.O. Box 10631

Jackson, Mississippi 39209

WATER WELL DRILLERS LOG

CODED

WAYNE  
S 97  
2-4-87

2-4-87 19 date well completed Tom Griffith well ser. Wayne county well located

LANDOWNER: Energy  
P.O. Box 905  
Natchez, Ms 39120  
(mailing address)

description of formations encountered	from	to
Clay	1	140
Sand	140	150
Clay	150	160
Sand	160	170
Clay	170	275
Sand	275	290
Clay	290	300
Sand	300	350

WELL LOCATION:  
sec. 19 T. 70N R. 7E  
8 miles SW of GORDON  
(distance) (direction) (nearest town)

WELL PURPOSE: Ag Summer  
(home, irrigation, municipal, industrial)

- WELL COMPLETION DATA:
- (1) diameter (inches) 3"
  - (2) total depth (feet) 350
  - (3) static water level (feet) 100 below above top of ground.
  - (4) casing PVC, 310,  
(material) (depth)  
3" if telescope see back.  
(size)
  - (5) screen 40, 310  
(length) (depth to top)  
3", PVC  
(size) (material)
  - (6) pump air lift, 70  
(HP) (yield gpm)
  - (7) electric log NO  
(yes or no)  
NA  
(organization running log)
  - (8) how well bottom plugged BWU

2310' S + 10' W of NE corner

RECEIVED


SEP 24 1987

Department of Natural Resources  
Bureau of Land & Water Resources

DRILLERS REMARKS:

If well telescopes please sketch and show depths.

GROUND LEVEL

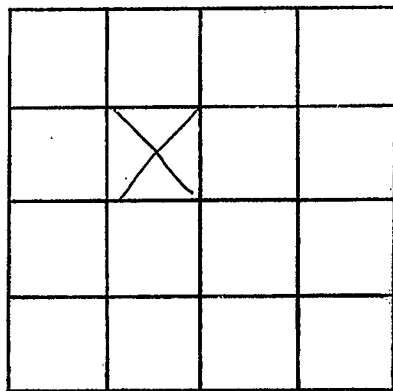

SECTION 19

Please indicate well location X.

ADDITIONAL INFORMATION

If more than one screen, show locations of each on sketch.